


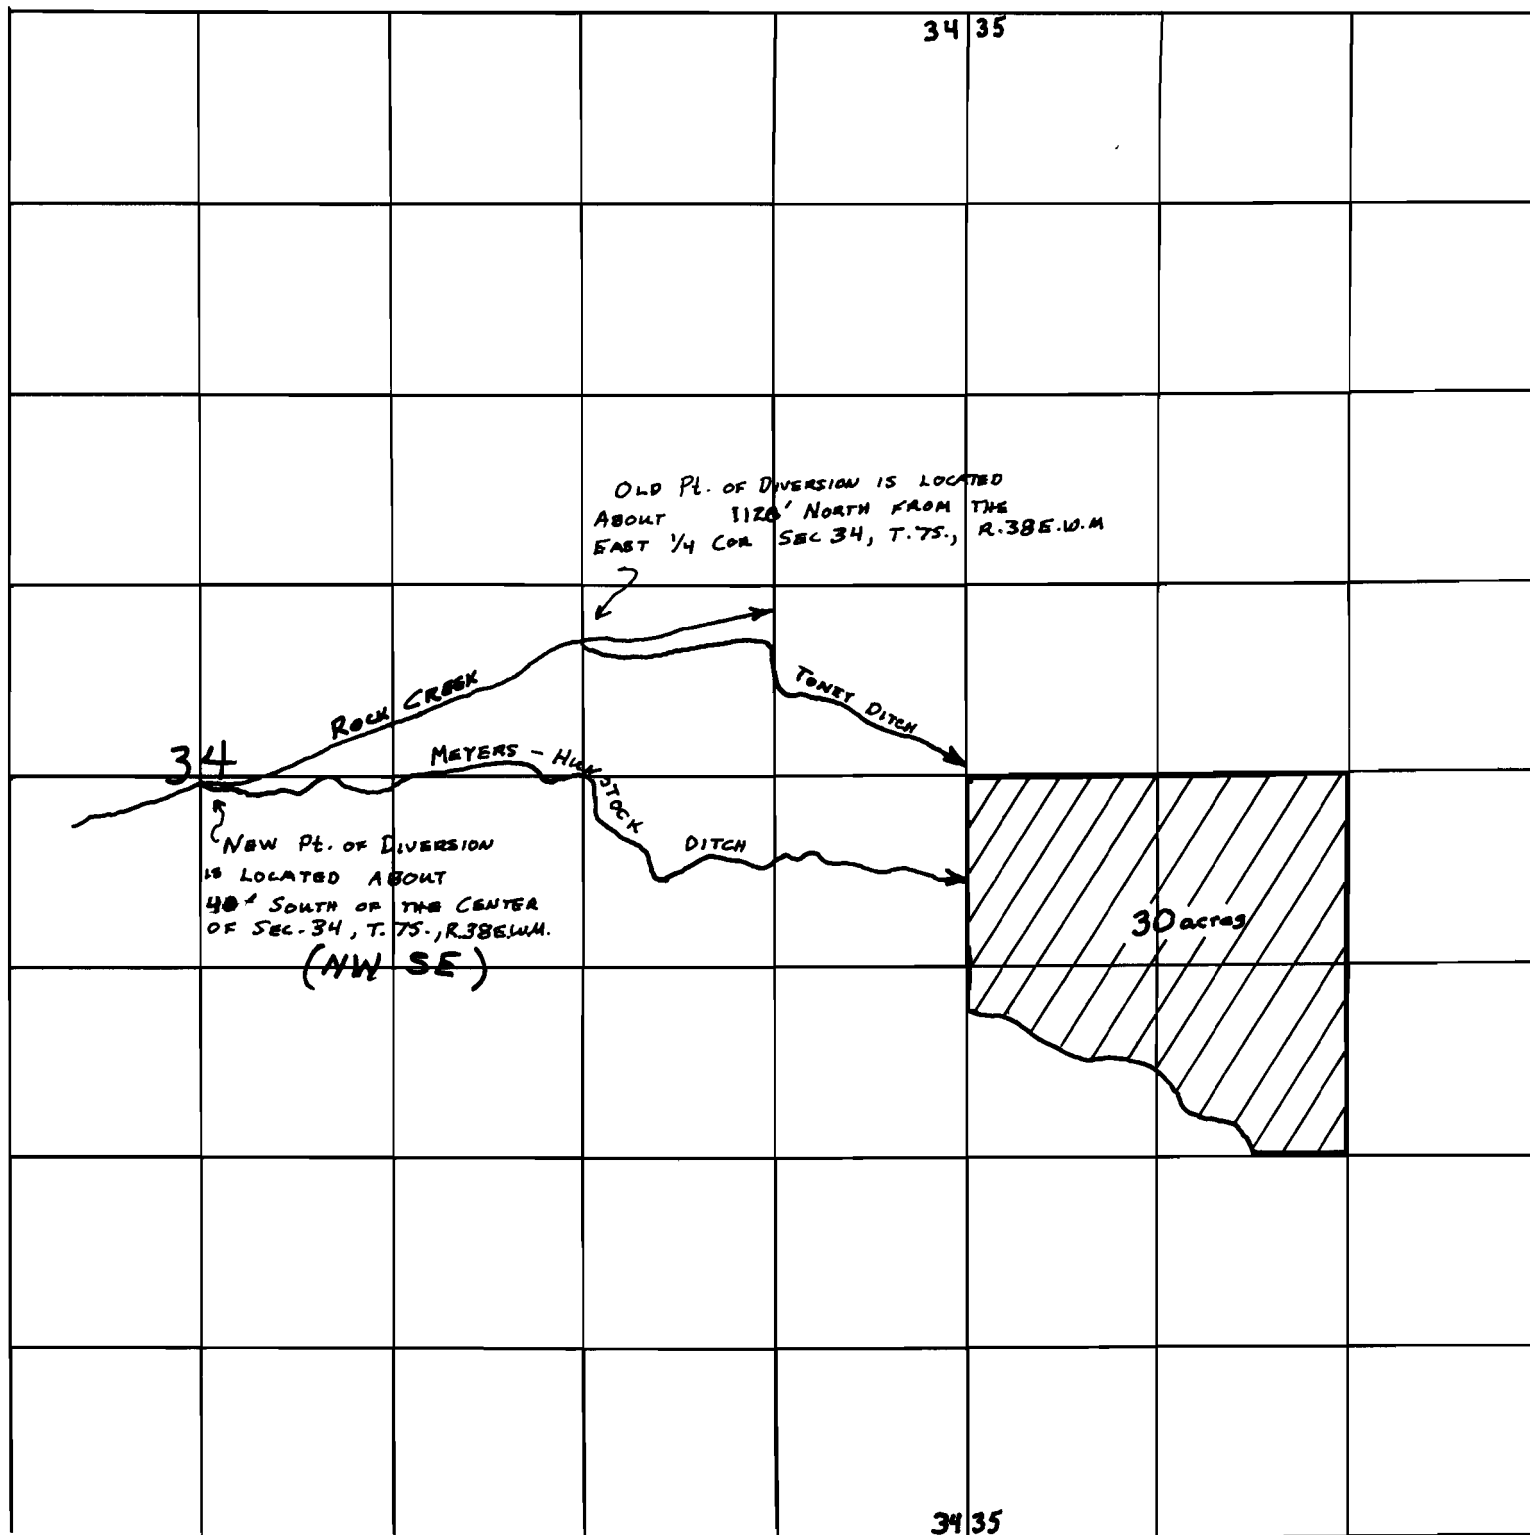

MAP TO ACCOMPANY APPLICATION OF:

Name FRANCIS B. ZIMMERMANCounty BAKERDate 12/30/76Scale 8" to 1 Mile

Note:

MAP PREPARED FROM: AERIAL PHOTOMAP DRAWN BY: V. K. SEARLES

SIGNED BY APPLICANT: