


T.9&10S.R.2 W.W.M.

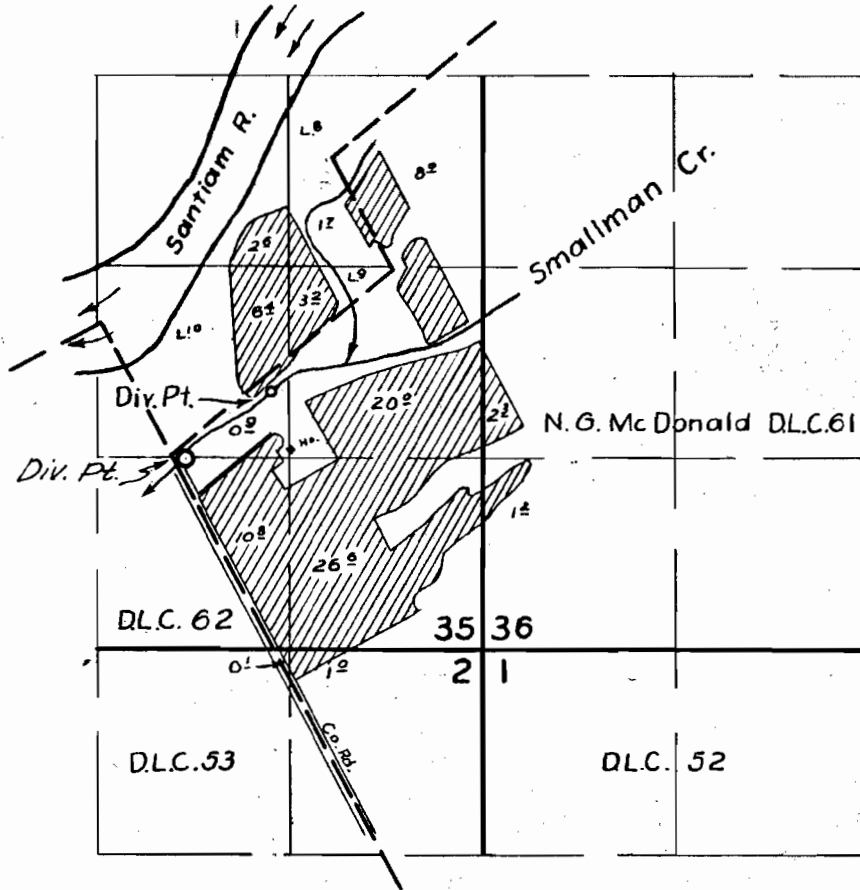

FINAL PROOF SURVEY

UNDER

Transfer No. 3516

Application No. _____

Permit No. _____

IN NAME OF

Walter R. Miller

Surveyed *July 3, 1979* by *W. Brown*

DPM 346-62
INSPECTION