


T.18S. R.12E. W.M.

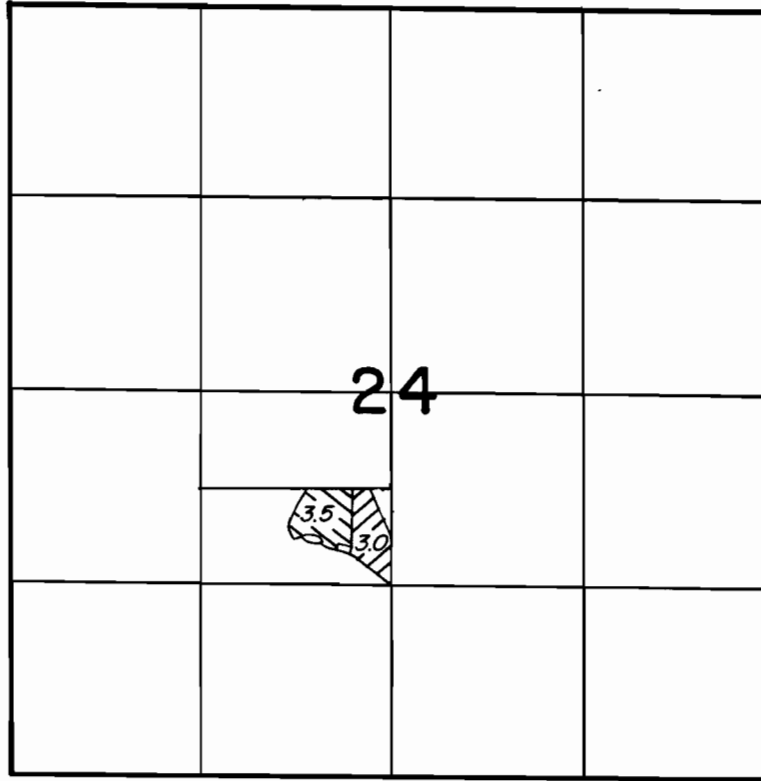

3523

4129

**FINAL PROOF SURVEY**

UNDER

PART OF TRANSFER 3523

AND TRANSFER 4129

Application No. .... Permit No. ....

IN NAME OF

**KENYON THOMPSON**

Surveyed JUN. 2 1982, by L.H. NUNN