


DESCHUTES COUNTY Mary Dou Powell & Nancy Hudson

1"=200'

2.0 acres water in red from Calvin Lewis

Harriet Horne bought for Bob Dillion

See Map 18 12 2.0 acres water in red

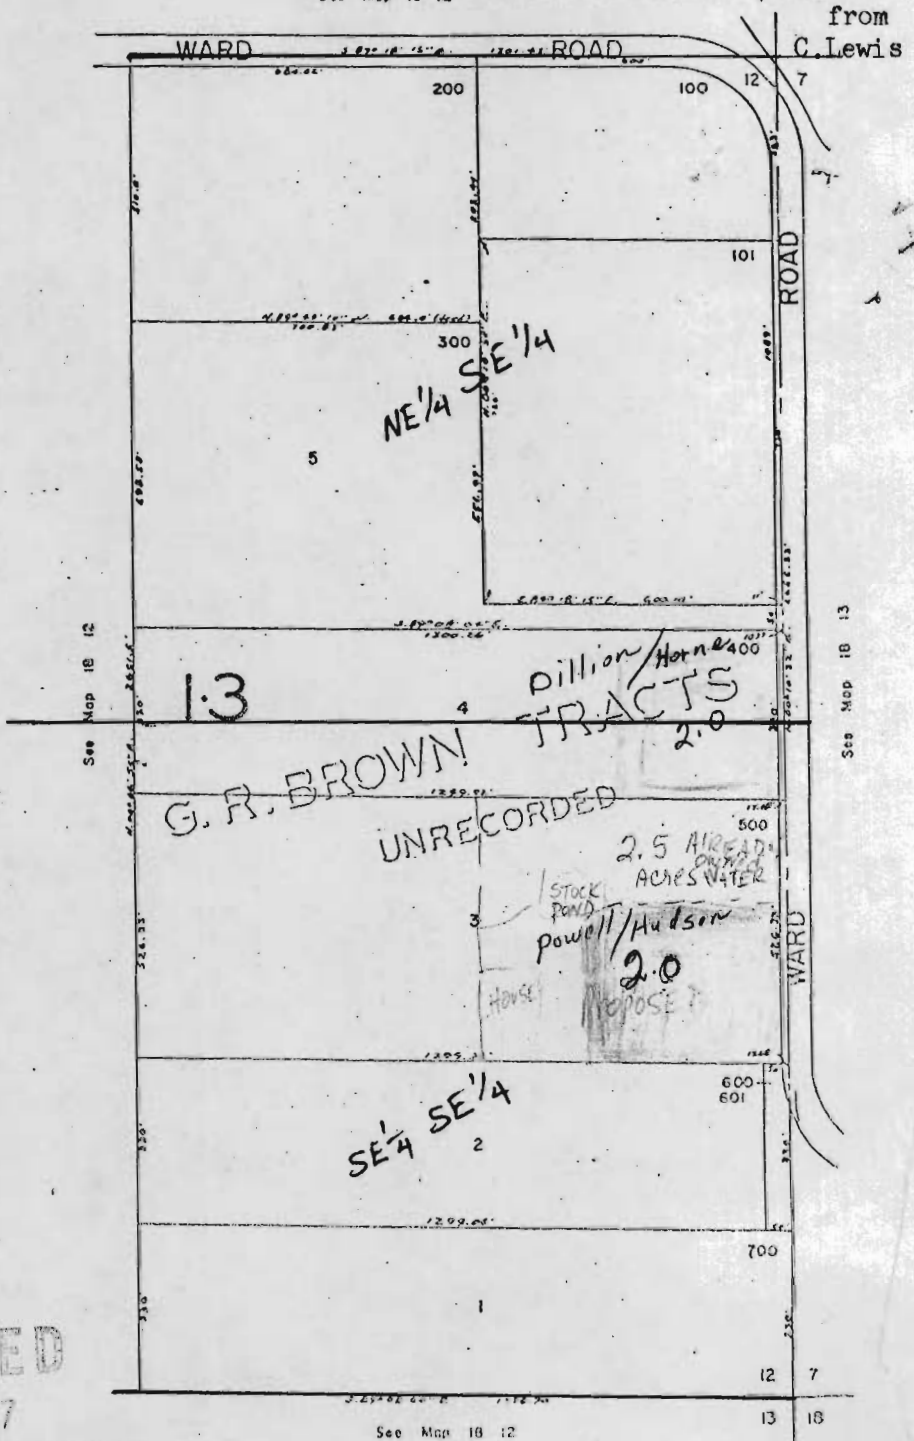

RECEIVED

FEB-3-1977

WATER RESOURCES DEPT  
SALEM, OREGON

