


T1N, R4W, WM.

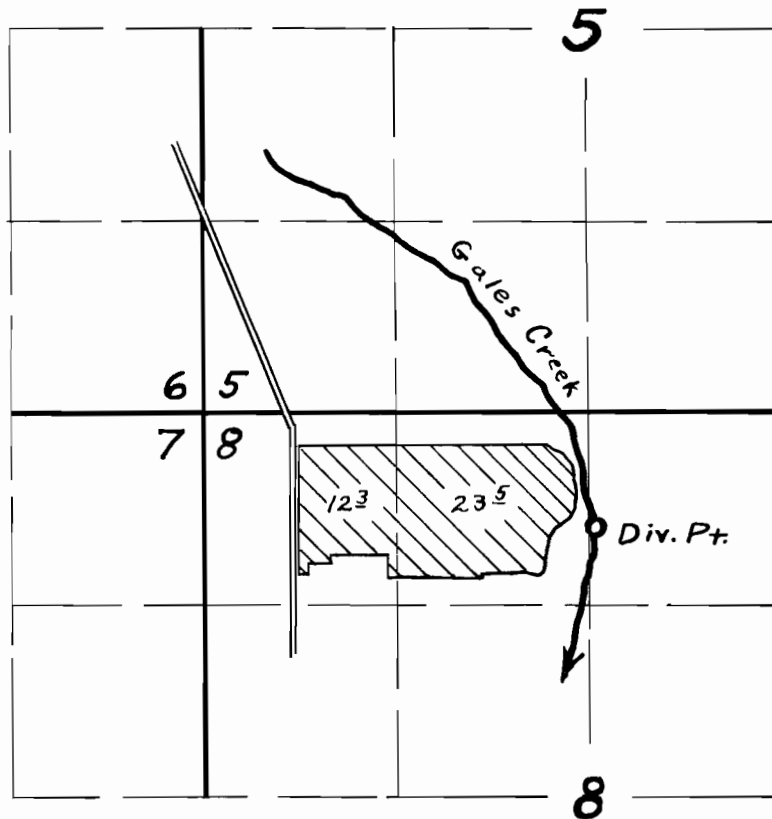

**FINAL PROOF SURVEY**  
UNDER

Application No. 26289 Permit No. 20634  
IN NAME OF

Grant Wright

Surveyed 4-12 1956, by R.D. Best