


T. 4 S. R. 3 W. WM

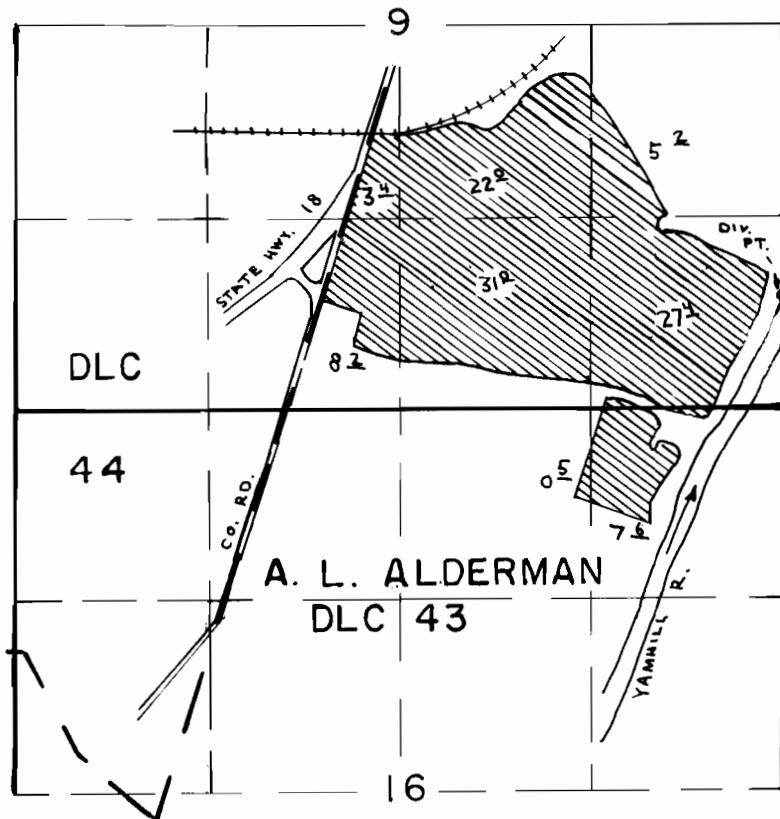

DIV. PT. LOC.: 750' N & 10' W OF SE COR. SEC. 9

**FINAL PROOF SURVEY**  
UNDER

TRANSFER 3539  
IN NAME OF

**PHILLIP A. HAWMAN**

Surveyed MAY 17, 1984, by P. PAGTER