


T.9S.R.5W.W.M.

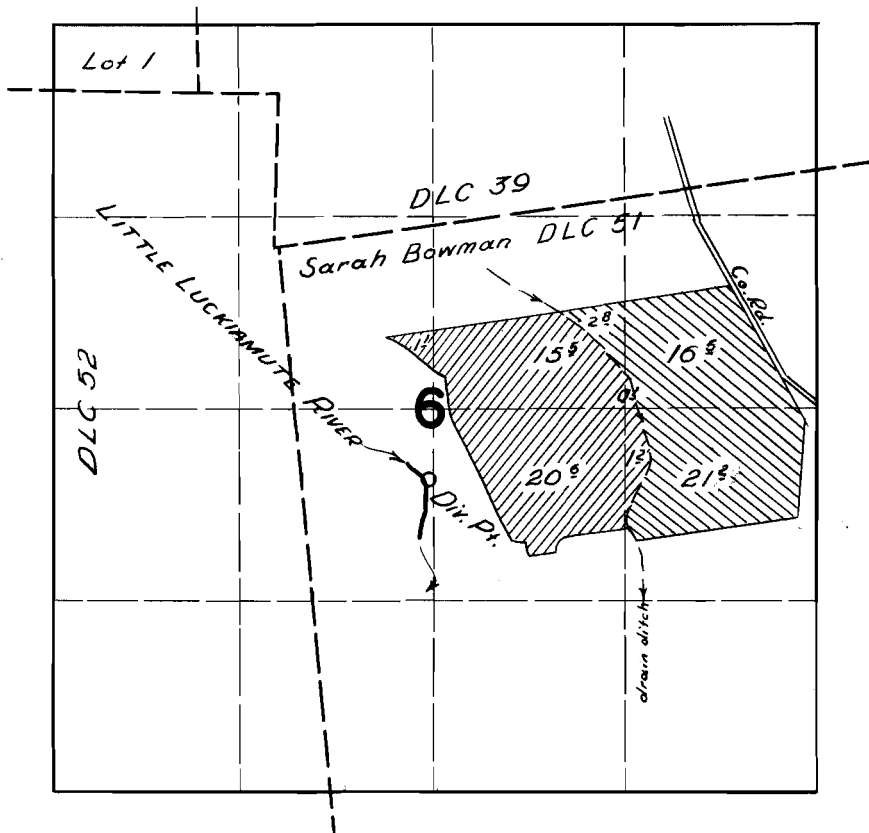

FINAL PROOF SURVEY

UNDER

Application No. 23611 27473 Permit No. 19633 21026

IN NAME OF

ELMER KNUAPP

Surveyed 1 Apr. 1957, by [Signature]