


# T38S. R19E. WM.

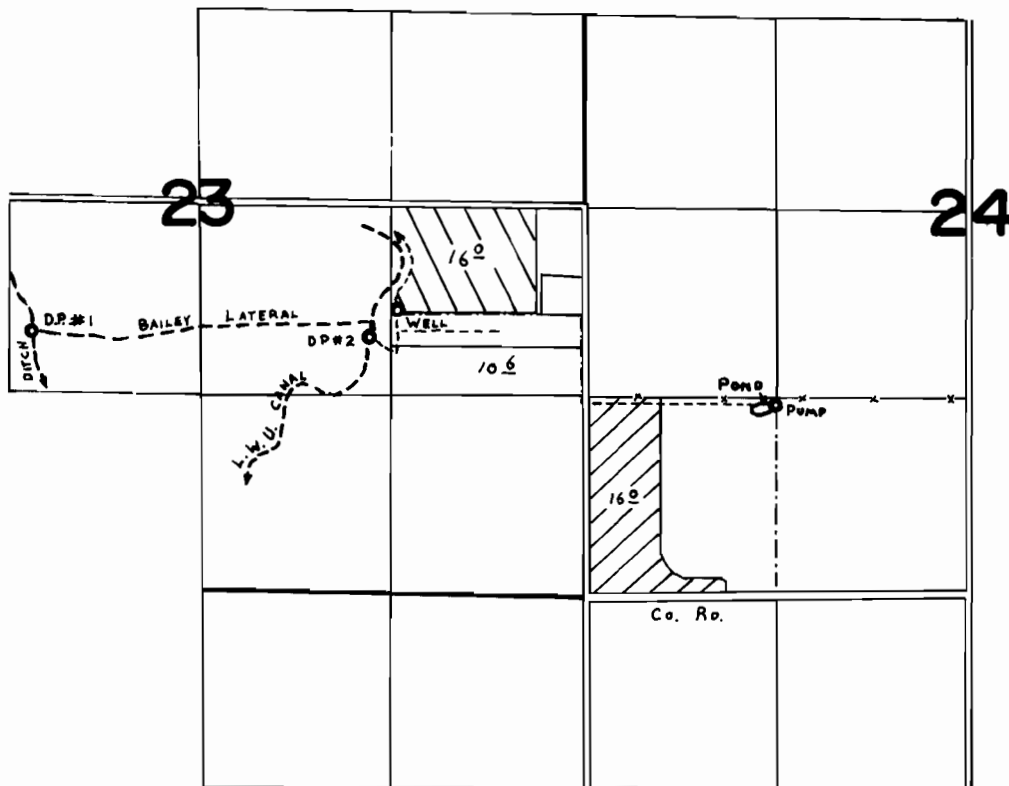

WELL LOC: 730'S. & 1280'W.  
 DIV. PTS. LOC: #1- 920'S. & 3800'W. } ALL FROM E. 1/4 COR. SEC. 23.  
 #2- 930'S. & 1480'W. }

▨ - PRIMARY fr. THOMAS CR.; Supplemental fr. WELL  
 ▩ - PRIMARY fr. WELL

Juanta Ditch - 5'S & 2000'W from the NE cor Sec 22

## FINAL PROOF SURVEY UNDER

Transfer No. T-3544  
 Application No. .... Permit No. ....  
 IN NAME OF

Daniel Olson

Surveyed JUNE 26 1978, by C. L. HUGHES