


T.4S.,R.3W.,W.M.

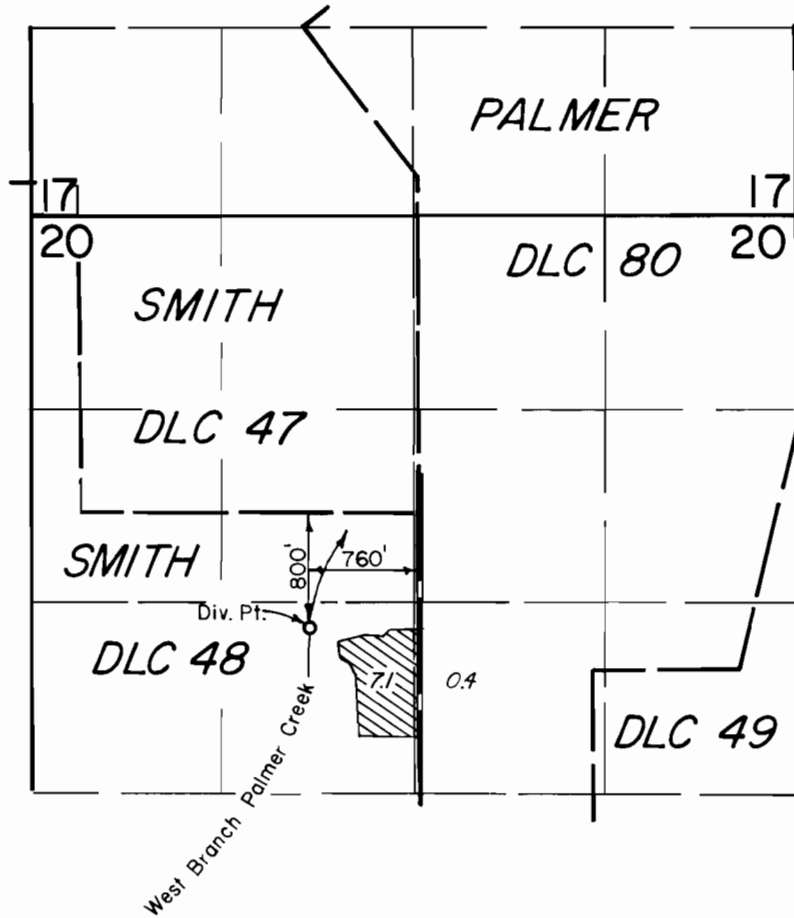

FINAL PROOF SURVEY UNDER

TRANSFER NO. 3546

Application No. Permit No.

IN NAME OF

SAMUEL B. SWEENEY

Surveyed JUNE 3, 1980, by *[Signature]*