

RECEIVED



T3S - R 39E

28

27

26

NE CORNER OF SW 1/4

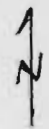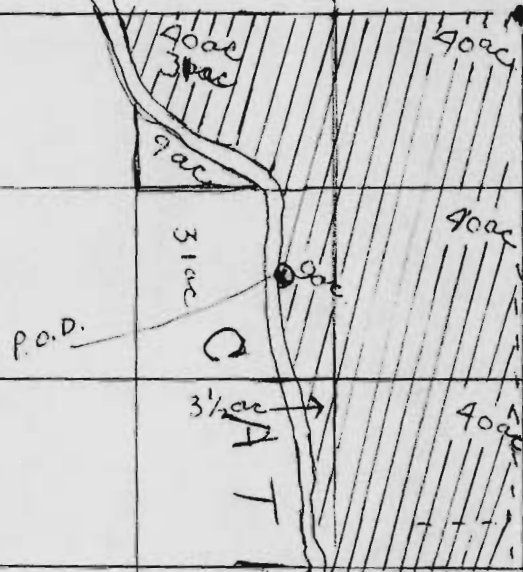

33

34

35

A
T
H
E
R
I
N
E

DITCH B

T4S R. 39E

C
R

4

2

SCALE - 4" = 1 mile

DITCH A

DITCH B

Godley DITCH No. 2

OLD P.O.D.

SHERMAN E. HAWKINS
and
M. Hazel HAWKINS