


T.7S. R.1W. W.M.

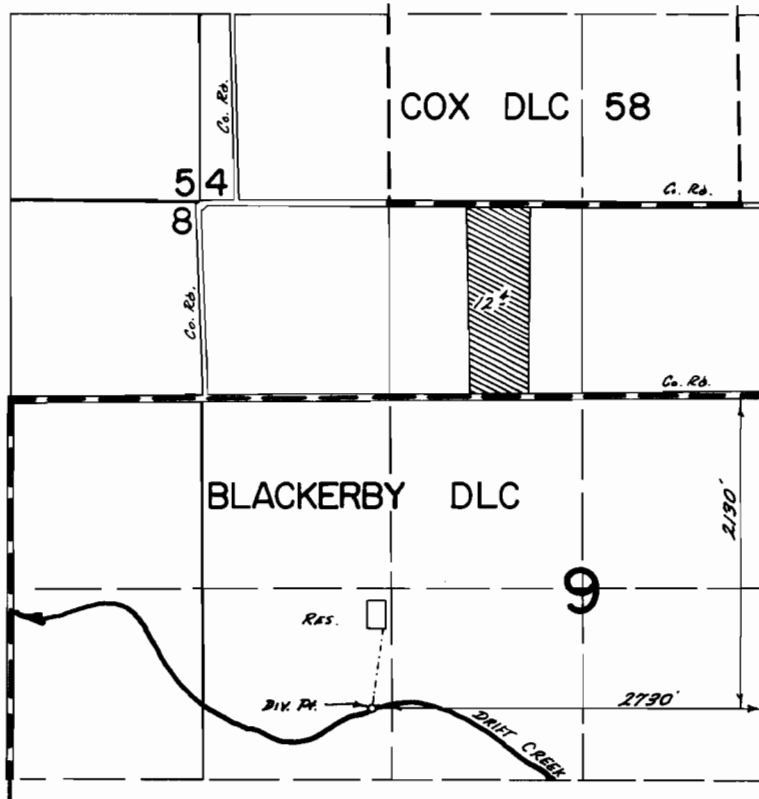

FINAL PROOF SURVEY
UNDER

Transfer No 2811
Application No. Permit No.
IN NAME OF

NORMA M. VON FLUE

Surveyed April 9, 1974, by T. J. PAUL