


# T.9S. R.2W., W.M.

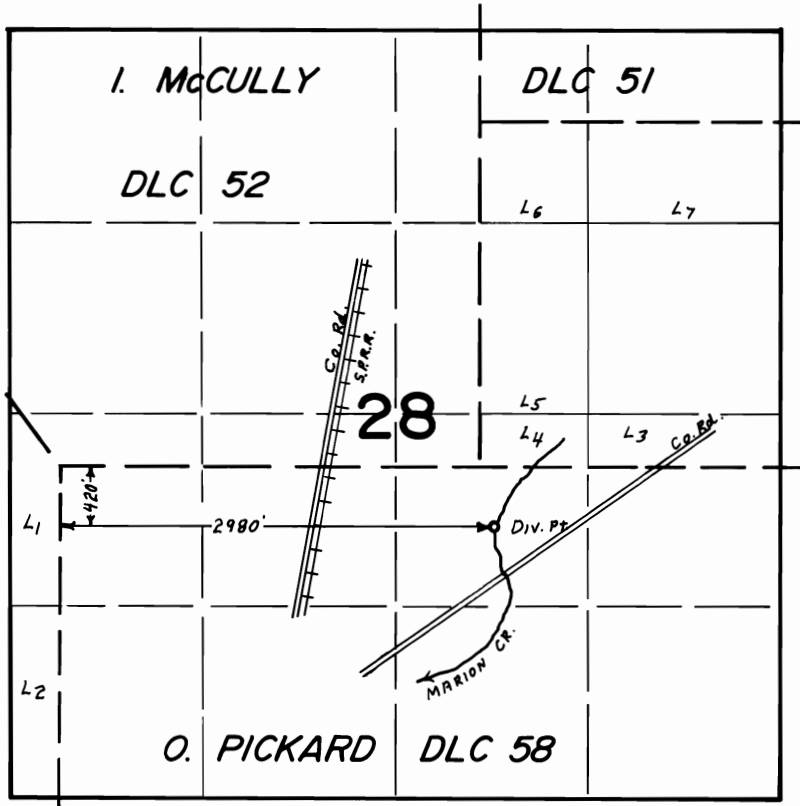

## FINAL PROOF SURVEY UNDER

Transfer No. 3562  
 Application No. .... Permit No. ....  
 IN NAME OF

..... DORSEY B. GRAY .....

Surveyed MAY 29 1979., by L.H.NUNN.....