


# T.18S., R.13E., W.M.

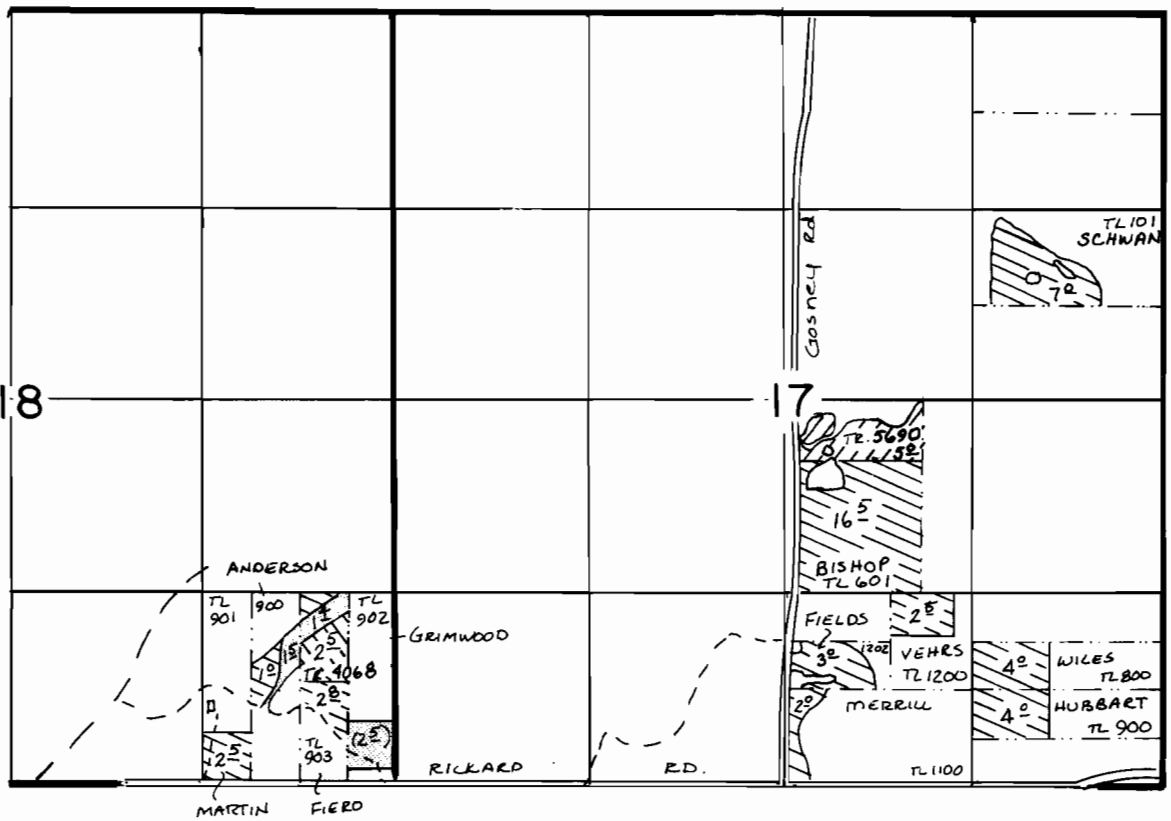

SCALE: 1" = 1320'

CERT. 29053

## FINAL PROOF SURVEY

UNDER

- Transfers 3582
- 4068
- 5690

IN NAME OF

.....**FIELDS, et. al.**.....

Surveyed AUG. 7, 1986, by L. OLSON.....