


T. 1 S. R. 3 W. W. M.

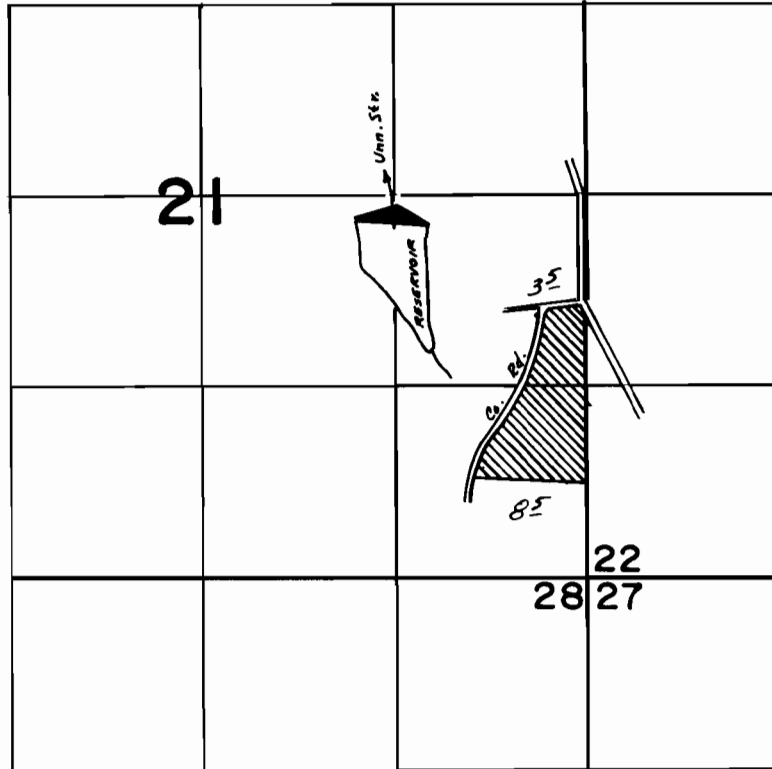

D.W. Pt. - 160' S & 1330' W from E 1/4 Cor. Sec. 21

FINAL PROOF SURVEY UNDER

TRANSFER No. 3583
Application No. Permit No.
IN NAME OF

..... WILLIAM F. UNGER

Surveyed Oct. 6, 1977, by J. S. DONALDSON