


# T.9S. R.6W., W.M.

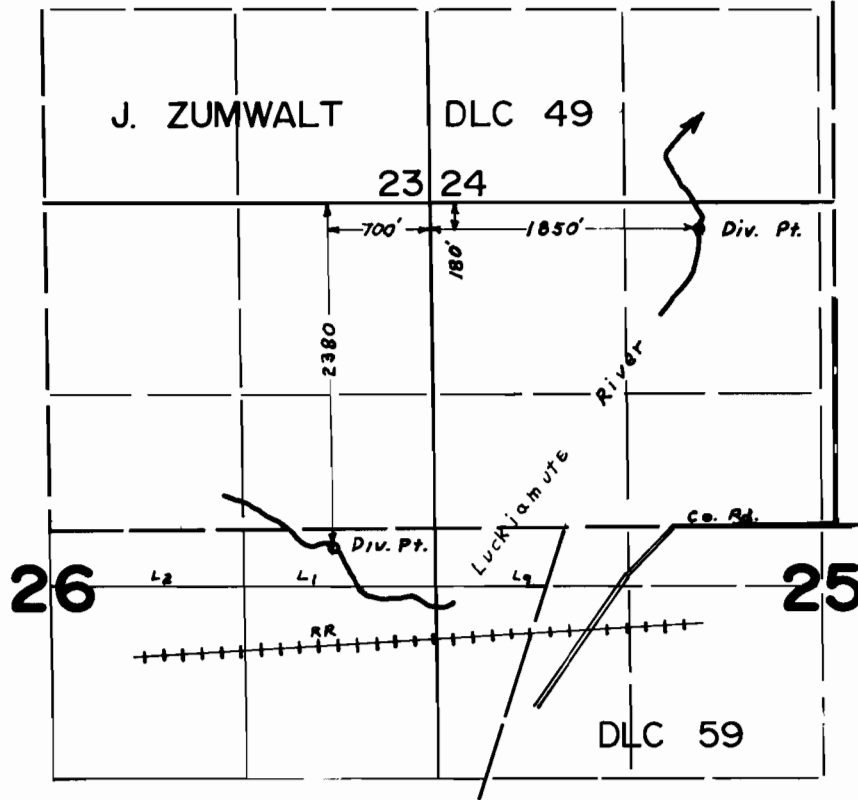

## FINAL PROOF SURVEY UNDER

Transfer No. 3584 & 3585  
 Application No. \_\_\_\_\_ Permit No. \_\_\_\_\_  
 IN NAME OF

..... P. KENDALL CATES .....

Surveyed MAR. 17. 1978. by J.S. DONALDSON