


T.6N. R.35&36E. W.M.

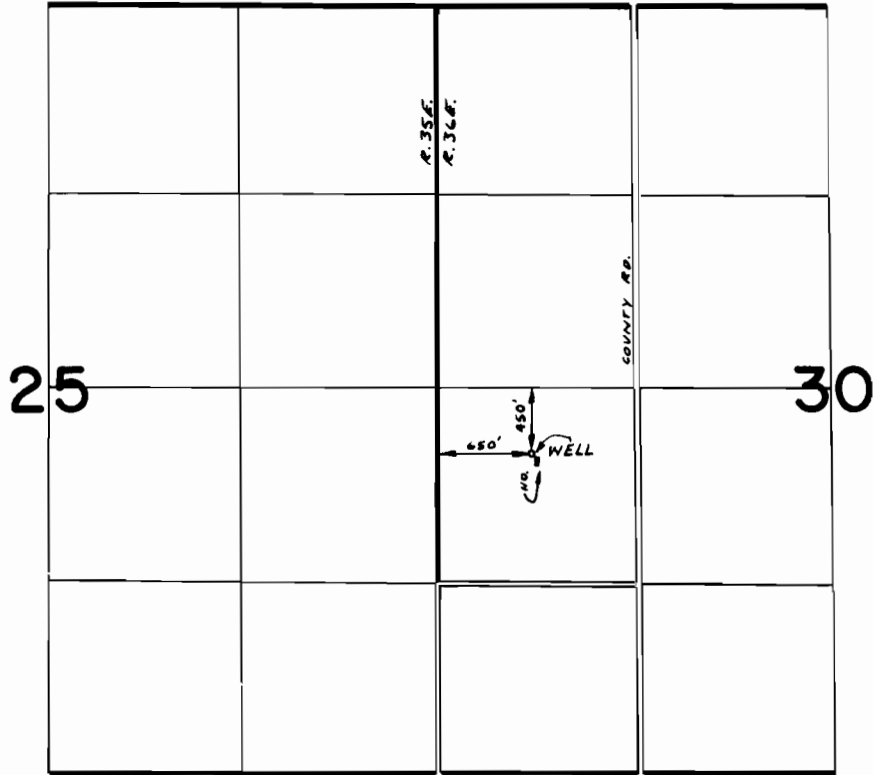

FINAL PROOF SURVEY
UNDER

TRANSFER 3587

Application No. Permit No.
IN NAME OF

VIRGEL AMMONS

Surveyed 11-15 1977, by R. BARWIN