


T. IS. R. 43E. W.M.

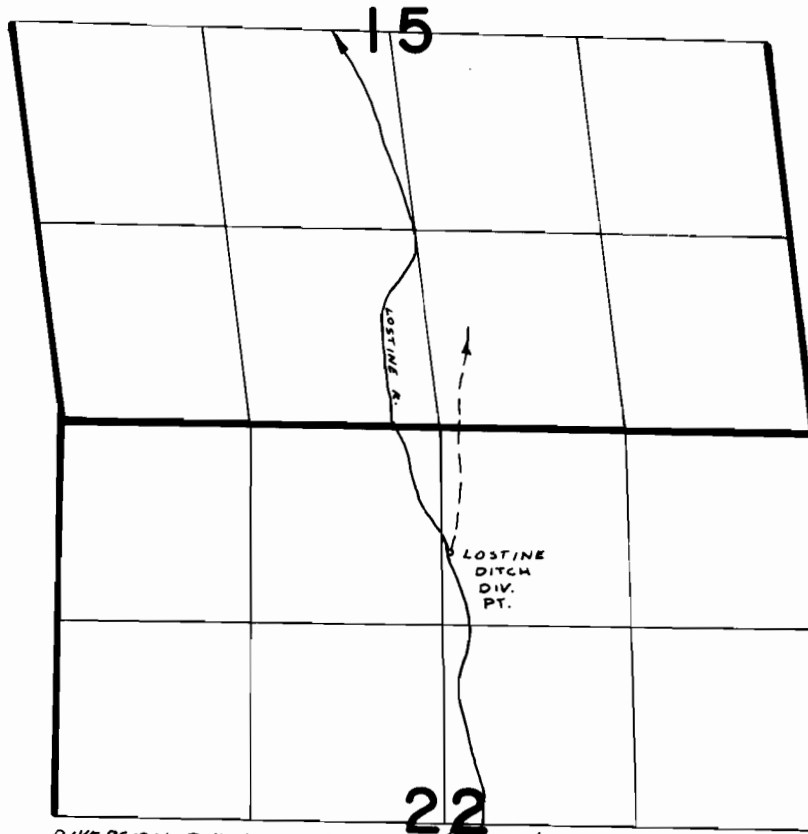

DIVERSION POINT LOCATED 830' S & 2700' E. FROM NW COR SEC 22

FINAL PROOF SURVEY
UNDER

TRANSFER 3598

Application No. Permit No.
IN NAME OF

..... **EDITH HAUN CLARK**

Surveyed *S-22* 1978., by *R. BARWIN*