


T. 15., R. 43E., W.M.

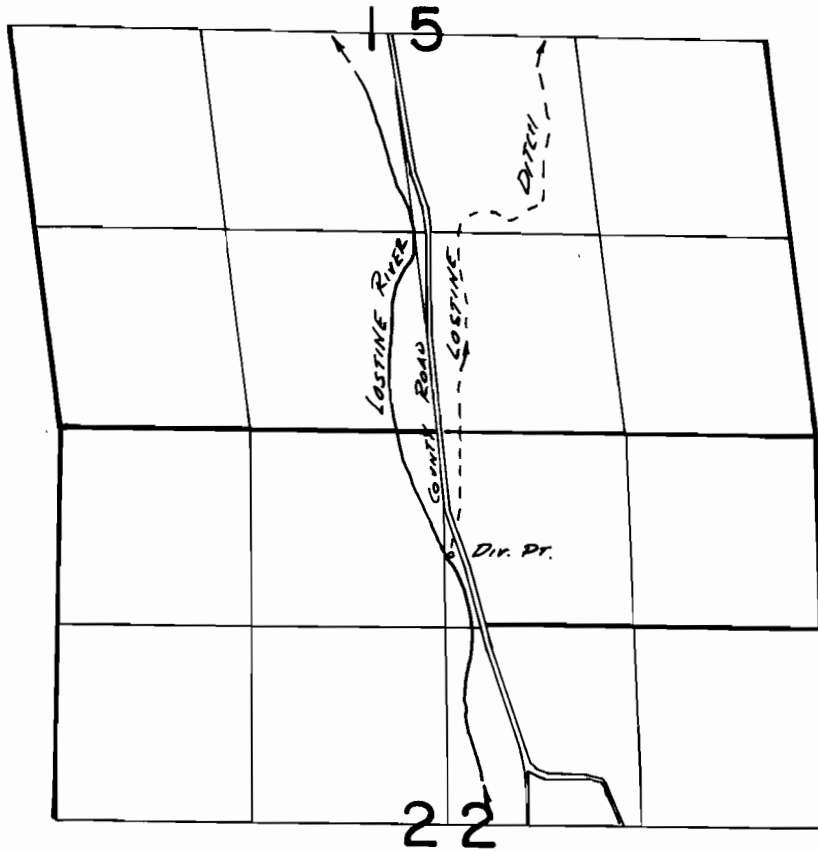

Dir. Pt. Loc: 830' S. & 2700' E. FROM NW COR. SEC 22

FINAL PROOF SURVEY
UNDER

TRANSFER 3599

IN NAME OF

LOWELL M. COURTNEY

Surveyed 8-12-1982, by J.H. Church