


MAP TO ACCOMPANY APPLICATION OF
 A.E. BROWN FOR CHANGE IN POINT
 OF DIVERSION ON CERT. 17220, PRIORITY 1882

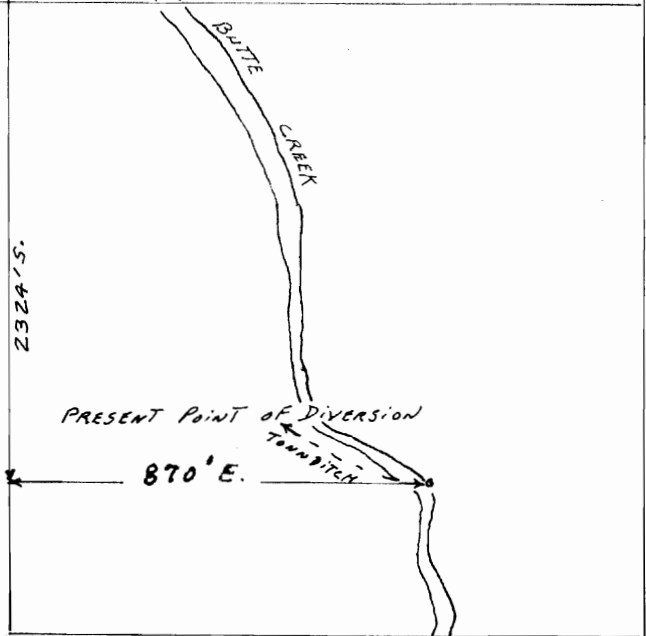

SCALE 1" = 400'



3-18-77