


T. 36 S., R. 1 W., W.M.

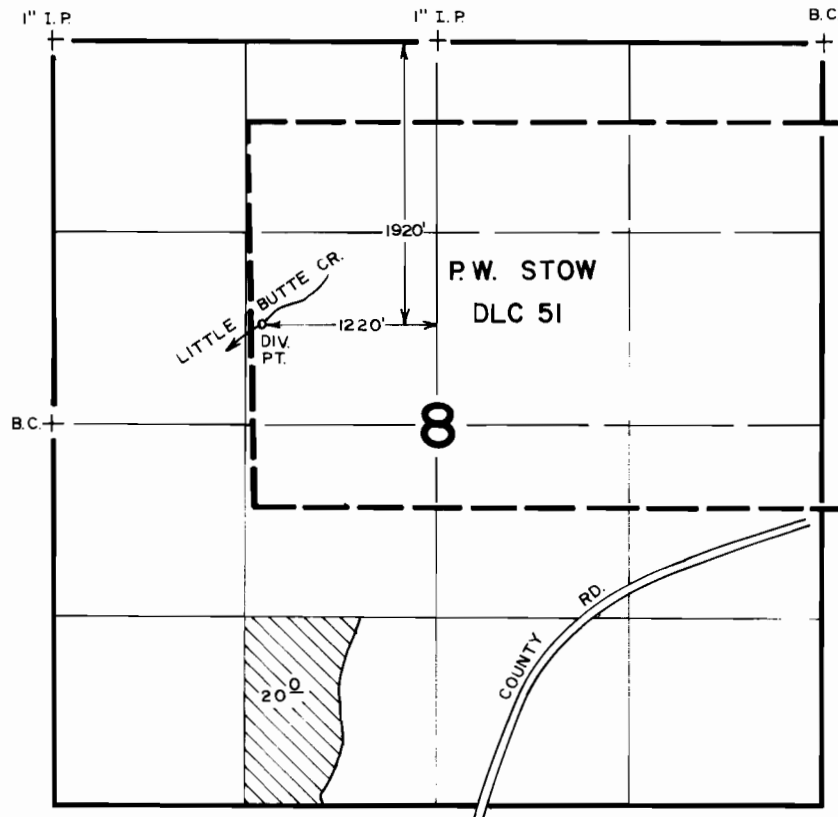

FINAL PROOF SURVEY UNDER

TRANSFER NO. 3602

Application No. Permit No.

IN NAME OF

..... JOHN KENDLE

Surveyed **MAY 4** 19**83**, by **B. S. JAMES**

SCALE: 4" = 1 MILE