


T.36S., R.1W., W.M.

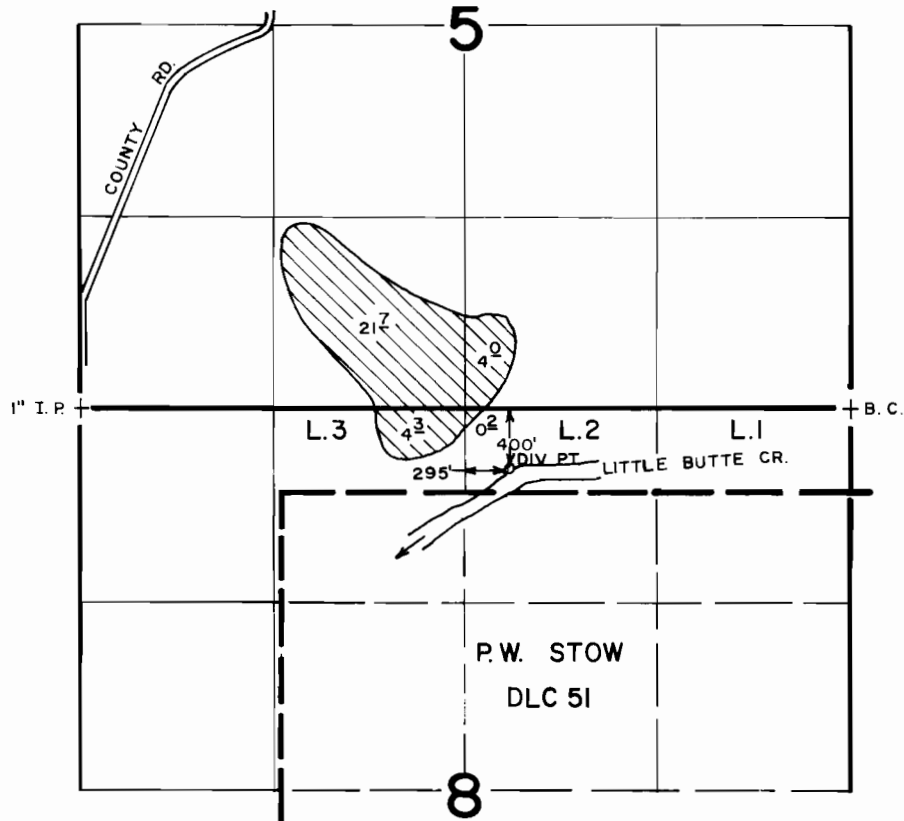

FINAL PROOF SURVEY
UNDER

TRANSFER NO. 3603
Application No. Permit No.
IN NAME OF

JOHN N. & HARRIET M. WINTON

Surveyed MAY 4, 1983, by B. S. JAMES

SCALE: 4" = 1 MILE