


SECTION 24 T18S. R12E W.M.
DESCHUTES COUNTY

17400'

See Map 18 12 12

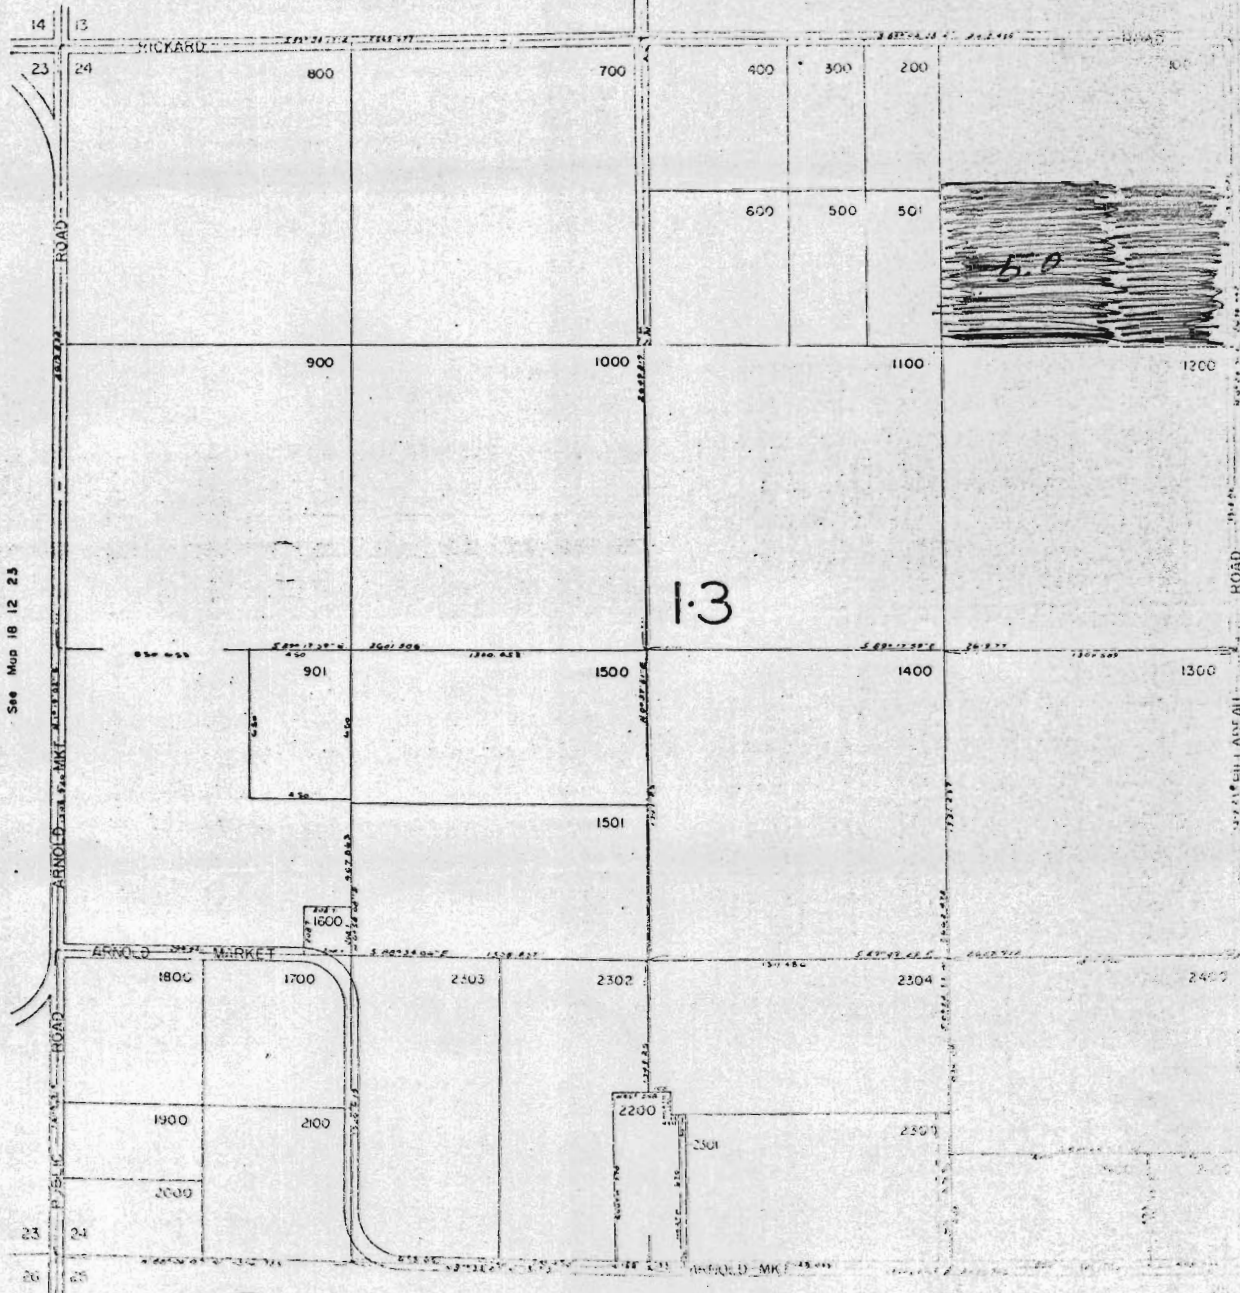

See Map 18 12 25


RECEIVED

APR - 4 1977

WATER RESOURCES DEPT
SALEM, OREGON

18-12-24
(NE 1/4 NE 1/4)

To L. Johnson 5.0 acres water from C. Bouldh - 18-12-22

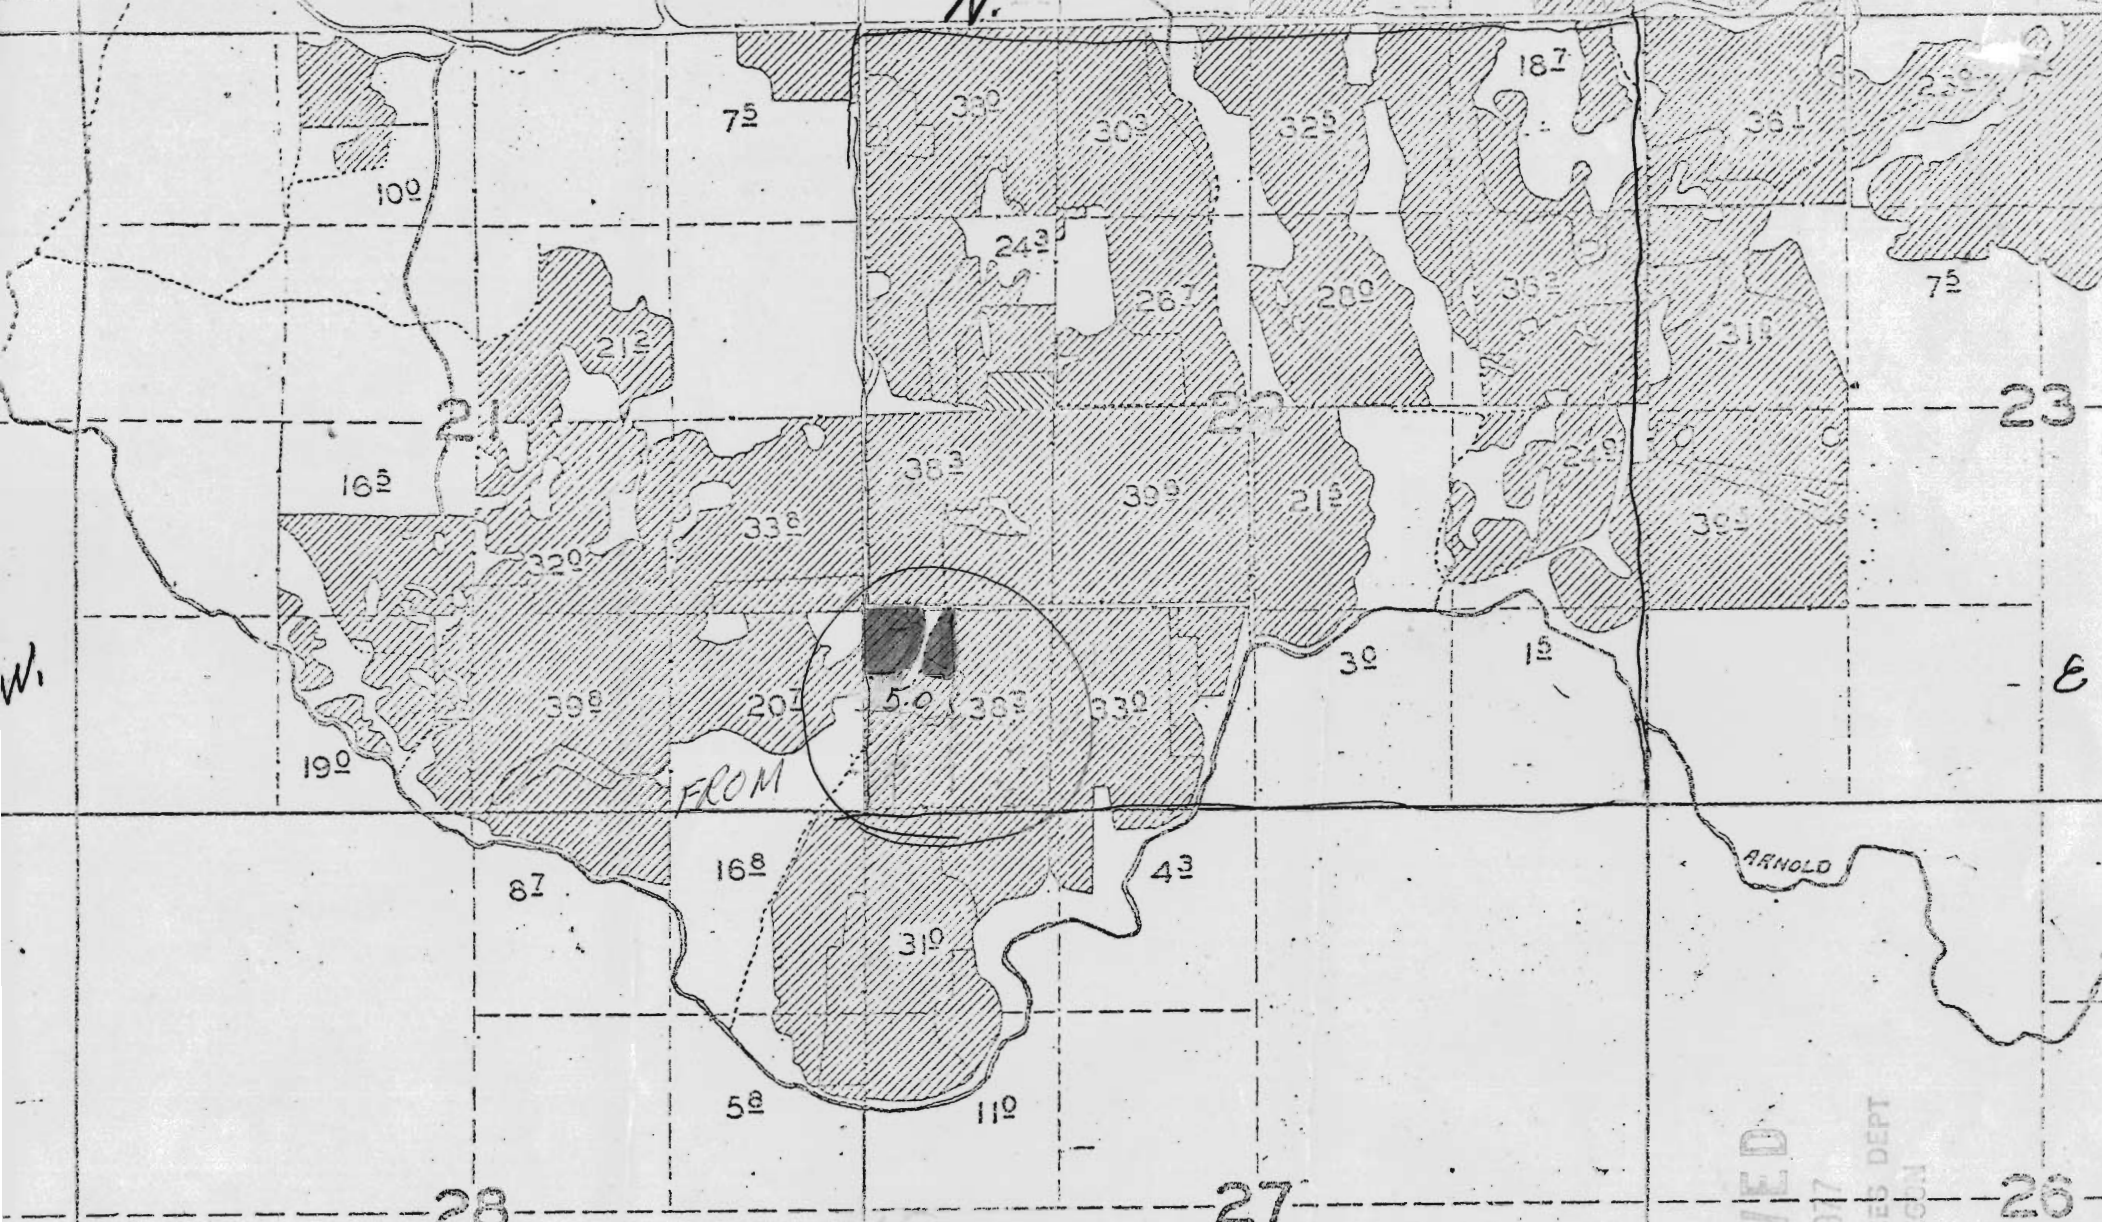

Curt Boulet sold 5 acres from area in green. Section 22 18 12

5/10 1/4 of 5/10 1/4

S.

RECEIVED
 APR-4 1977
 WATER RESOURCES DEPT
 SALEM, OREGON