


T.1S., R. 3W., W.M.

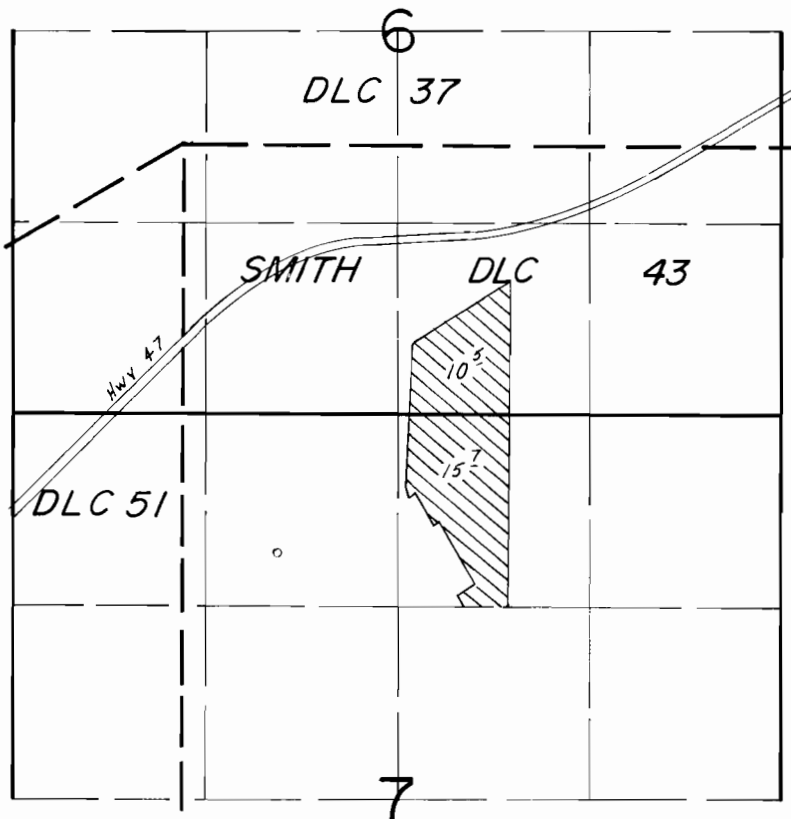

SCALE: 1" = 1320'

FINAL PROOF SURVEY UNDER

TRANSFER No. 3614
IN NAME OF

.....GLENN W. ZURCHER.....

Surveyed Sept. 25, 1984, by B.W. BISHOP.....