


T. 38 S., R. 4 W., W.M.

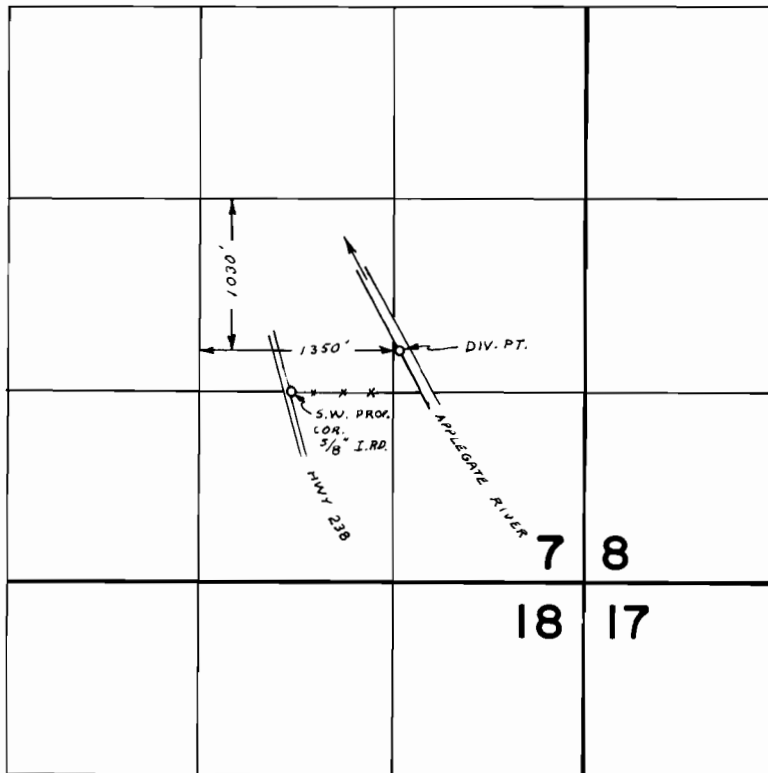

**FINAL PROOF SURVEY**  
UNDER

Transfer No. 3617

Application No. .... Permit No. ....  
IN NAME OF

JUANITA M. (YOUNG) HIATT

Surveyed JUN. 21 1978, by B. SUND