


T. 36 & 37 S., R. 2 E., W. M.

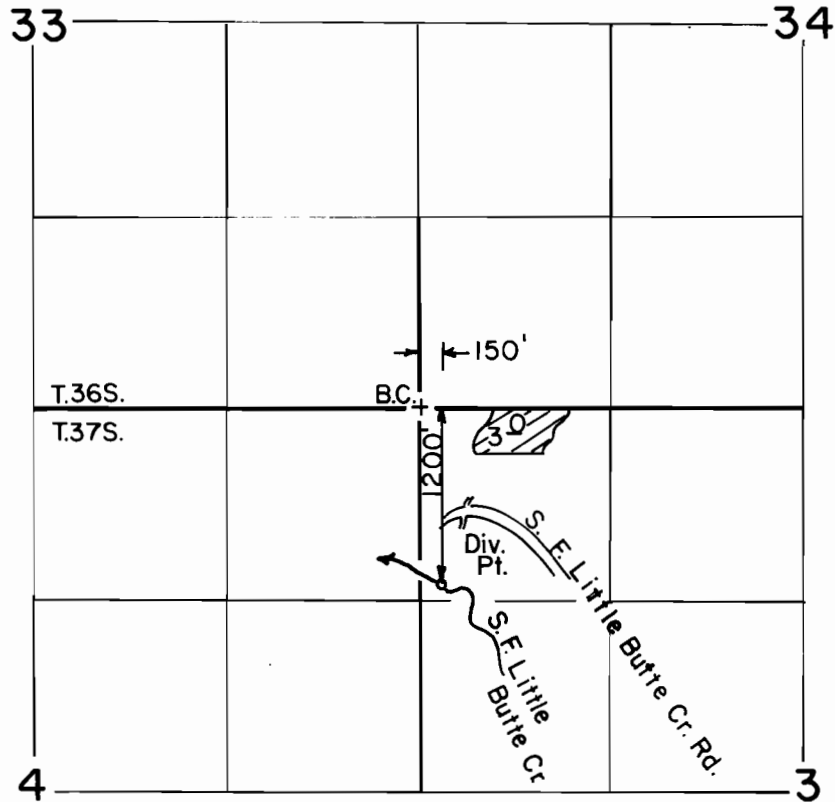

Scale: 1" = 1320'

FINAL PROOF SURVEY
UNDER

TRANSFER NO. 3620

Application No. Permit No.

IN NAME OF

.....CARL MACEDO, JR.....

Surveyed JULY 17, 1991, by B.S. JAMES....