


T. 34 & 35 S., R. 3 W., W. M.

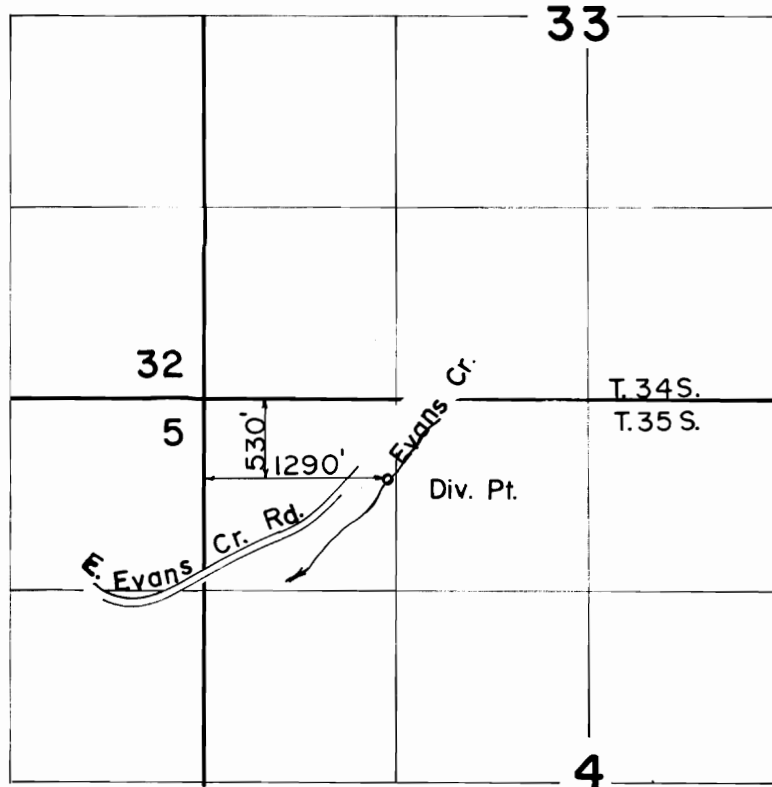

Scale: 1" = 1320'

FINAL PROOF SURVEY

UNDER

TRANSFER NO. 3622

Application No. Permit No.

IN NAME OF

..... JEFFREY L. ROBERTS

Surveyed JUN...9... 19.8.7, by B...S.:...JAMES...