


T. 11 S., R. 40 E., W.M.

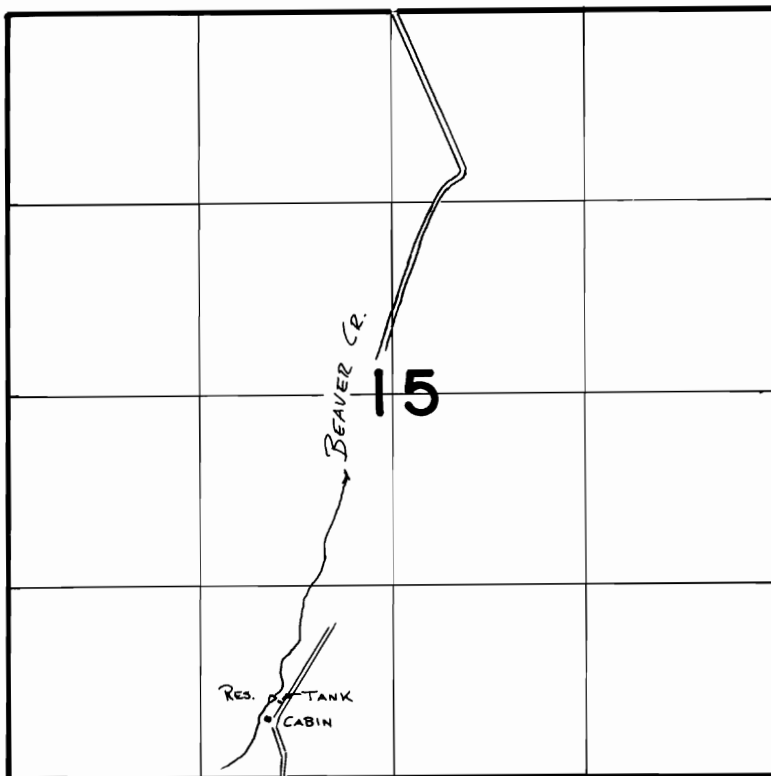

SCALE 1" = 1320'

FINAL PROOF SURVEY  
UNDER

TRANSFER 3627

IN NAME OF

OLEN D. & FLORENCE A. RAGSDALE

Surveyed 4-12-1990, by V.L. Chrysh