


T. 38 S., R. 1 W., W.M.

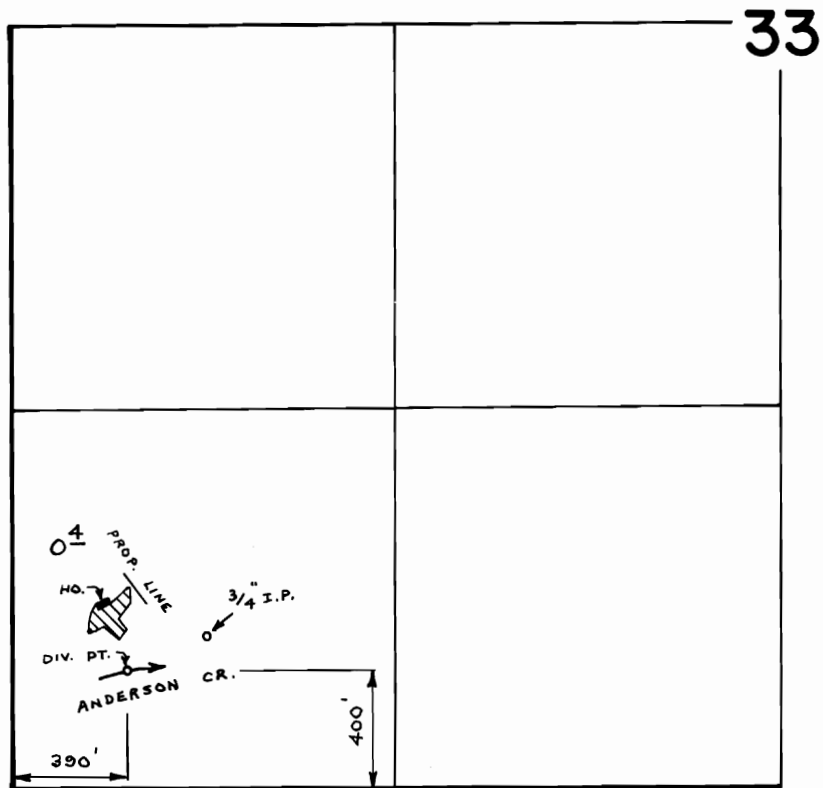

SCALE : 1" = 660 FT.

**FINAL PROOF SURVEY
UNDER**

Transfer No. 3635

Application No. Permit No.

IN NAME OF

RICHARD & ROSEMARY STANEK

Surveyed SEPT. 11 1978, by B. SUND