


T. 15., R. 43E., W.M.

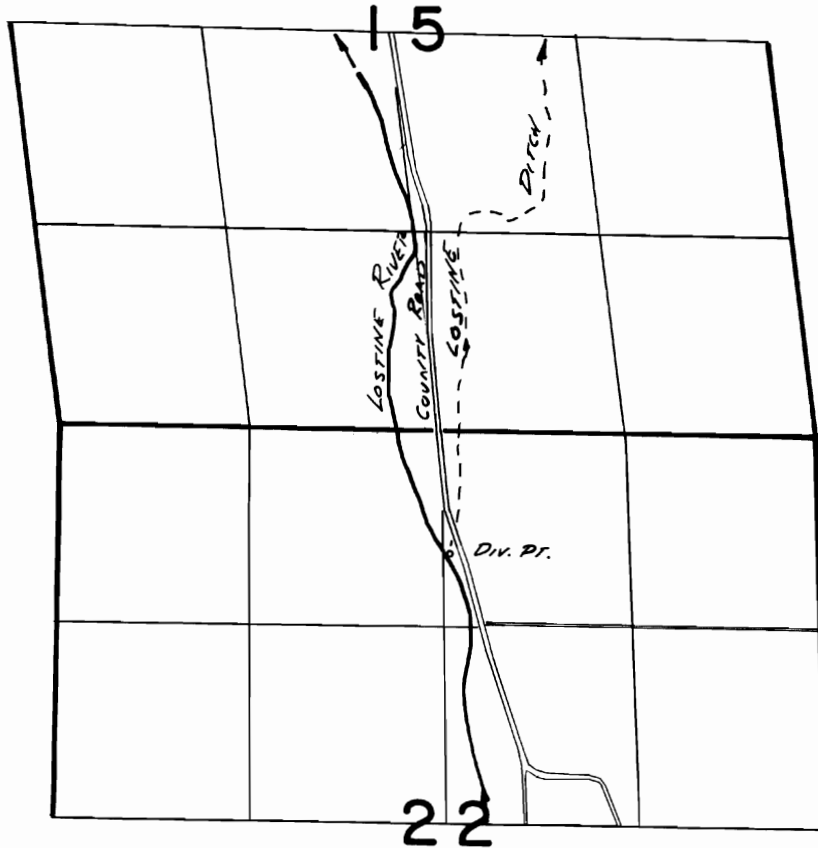

DIV. PT. LOC: 830' S. & 2700' E. FROM NW COR. SEC. 22

FINAL PROOF SURVEY
UNDER

TRANSFER 3637

IN NAME OF

HAUN BROTHERS

Surveyed 8-10 1982, by *V.L. Church*