


T.17S. R.12E. W.M.

SEC. 17

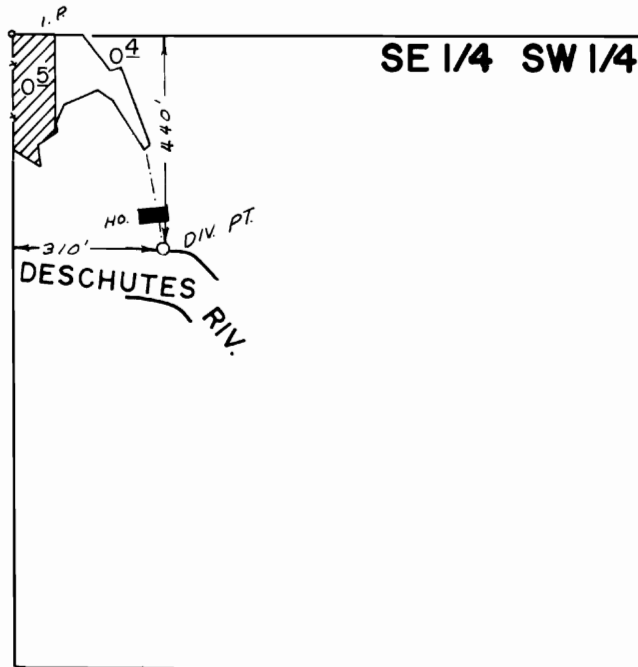

SCALE: 1" = 400'

FINAL PROOF SURVEY
UNDER

TRANSFER NO. 3642
Application No. Permit No.
IN NAME OF

DONALD G. CORN

Surveyed FEB. 29. 1980., by L. H. NUNN.....