


T. 35 S., R. 1 W., W.M.

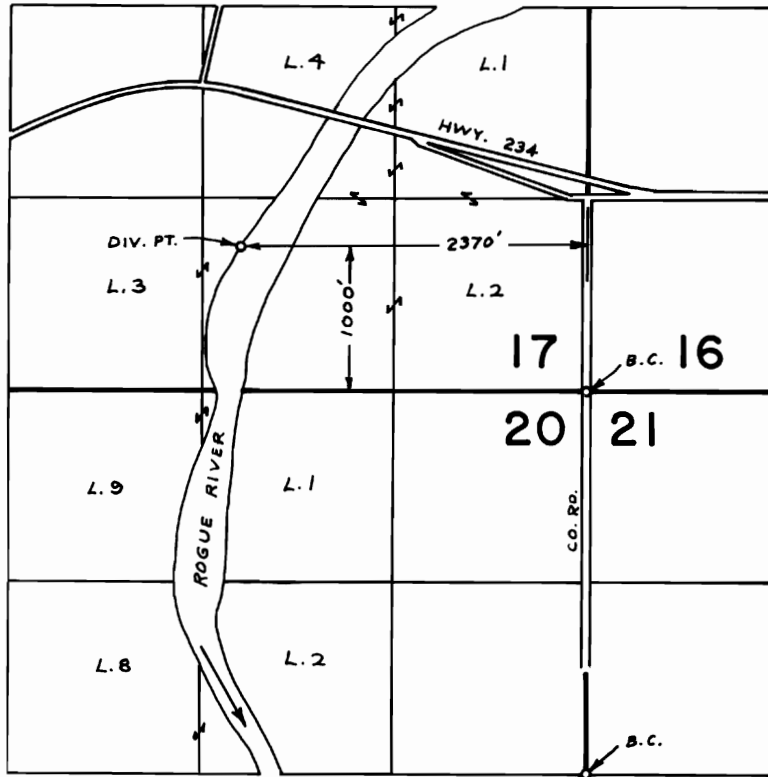

FINAL PROOF SURVEY
UNDER

Transfer No. 3646

Application No. Permit No.

IN NAME OF

JACK WILSON & JOEY HEDDEN LOVE

Surveyed MAY 22 1978, by B. SUND