


T. 4S., R. 40E., W. M.

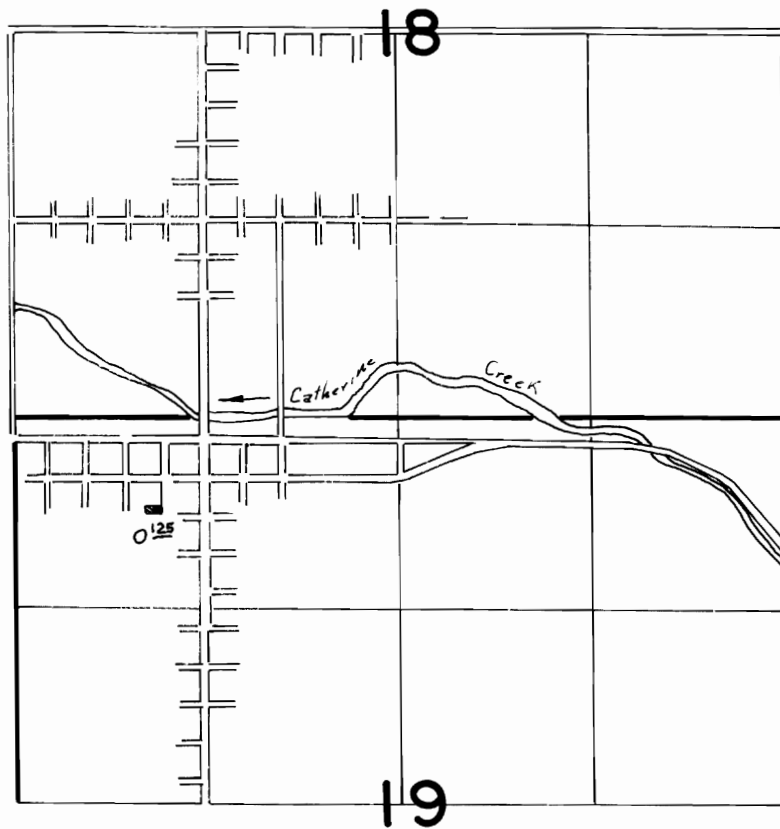

SCALE: 1" = 1320'

**FINAL PROOF SURVEY**  
UNDER

TRANSFER 3649

IN NAME OF

**M. SMITH**

Surveyed ..7..10..... 19.84, by V. L. CHURCH...