


T. 6N. R. 34E. W.M.

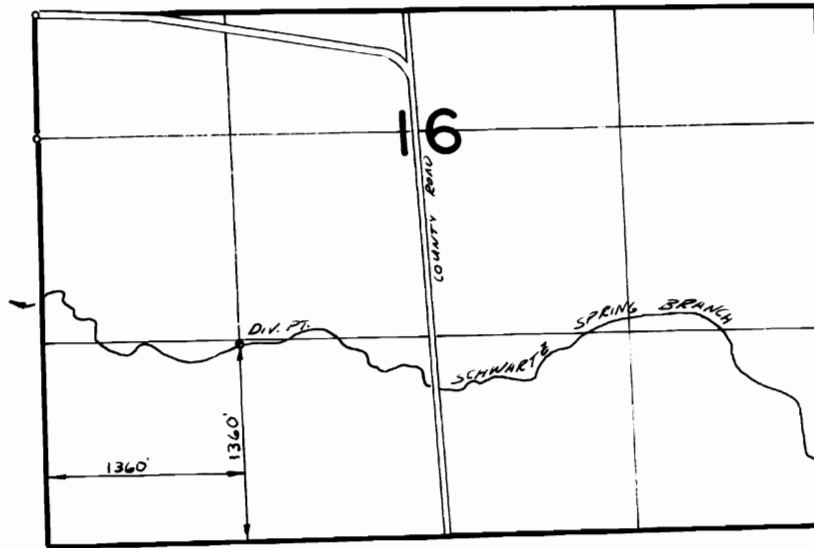

FINAL PROOF SURVEY
UNDER

TRANSFER 3650

Application No. Permit No.

IN NAME OF

HARVEY L. YOUNG

Surveyed *9-25* 19*78*, by *R. SARWIN*