


T. 35 S., R. 1 W., W.M.

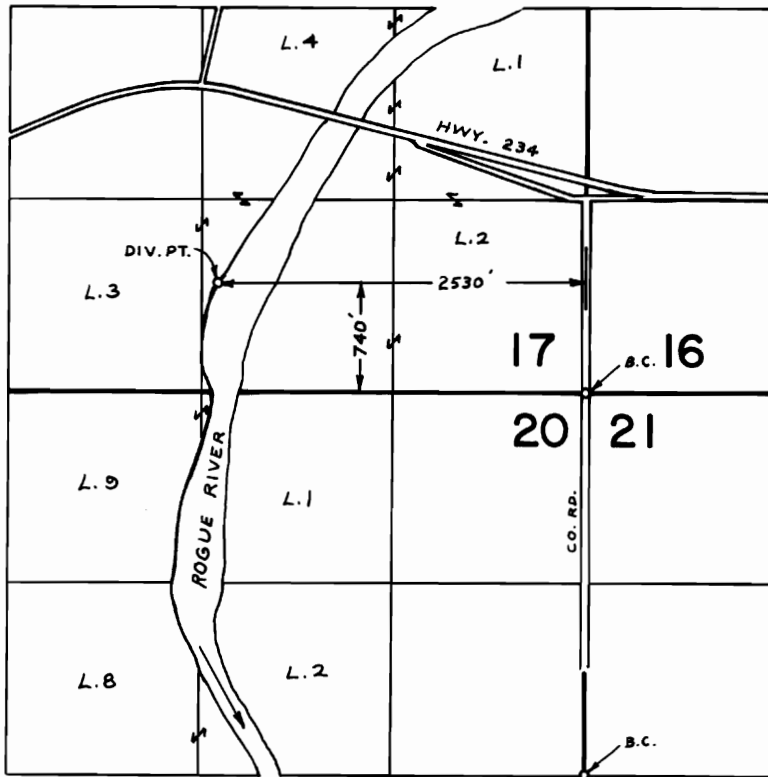

FINAL PROOF SURVEY UNDER

Transfer No. 3653

Application No. Permit No.

IN NAME OF

RUBY A. HAYES

Surveyed MAY 22, 1978, by B. SUND