


T5S, RIW, WM

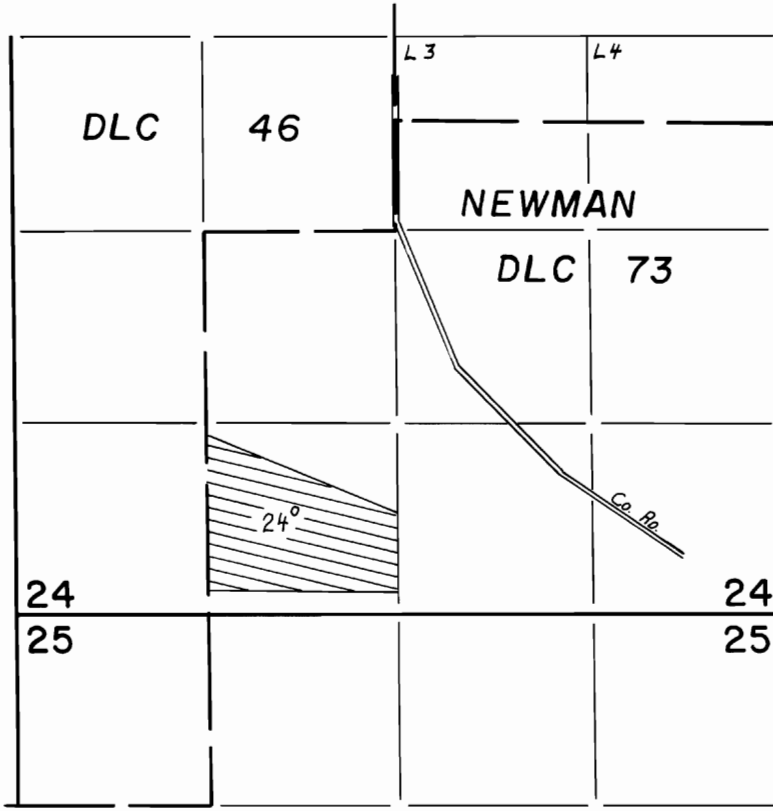

FINAL PROOF SURVEY UNDER

Transfer 3661

Application No. Permit No.
IN NAME OF

.....ROSS IVERSON.....

Surveyed JUNE 28, 1985, by T.M. WARREN...

RLK
DFK 211 25