


T.8S., R.19E., W.M.

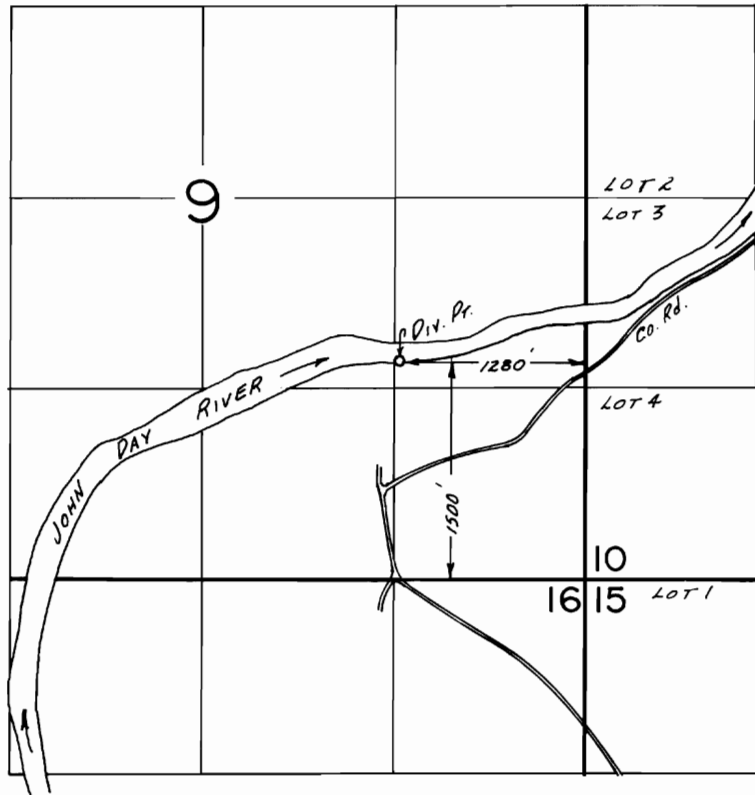

FINAL PROOF SURVEY
UNDER

Transfer No. 3667
Application No. Permit No.
IN NAME OF

RUBE W. & SARGIE JONES EVANS

Surveyed JUNE 26, 1980, by S.C. BROWN