


T.1N., R.12E., W.M.

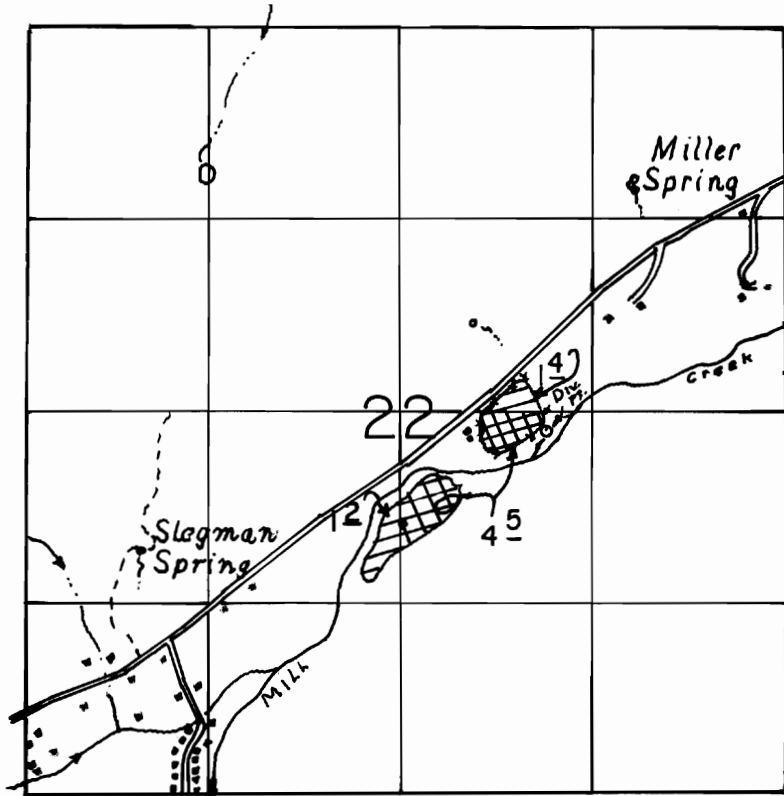

DIV.PT.LOC: 2480'N & 3570' E FROM SW COR OF SEC 22.

SCALE: 1" = 1320'

## FINAL PROOF SURVEY

UNDER

 PRIMARY  
 SUPPLEMENTAL

TRANSFER NO. 3670

Application No. XXXXX Permit No. X.X.X.X.XX  
IN NAME OF

.....MICHAEL T. PETERSON.....

Surveyed MAY 17, 1995, by R.M. SUTTERFIELD