


T. 7 & 8S., R. 38E., W.M.

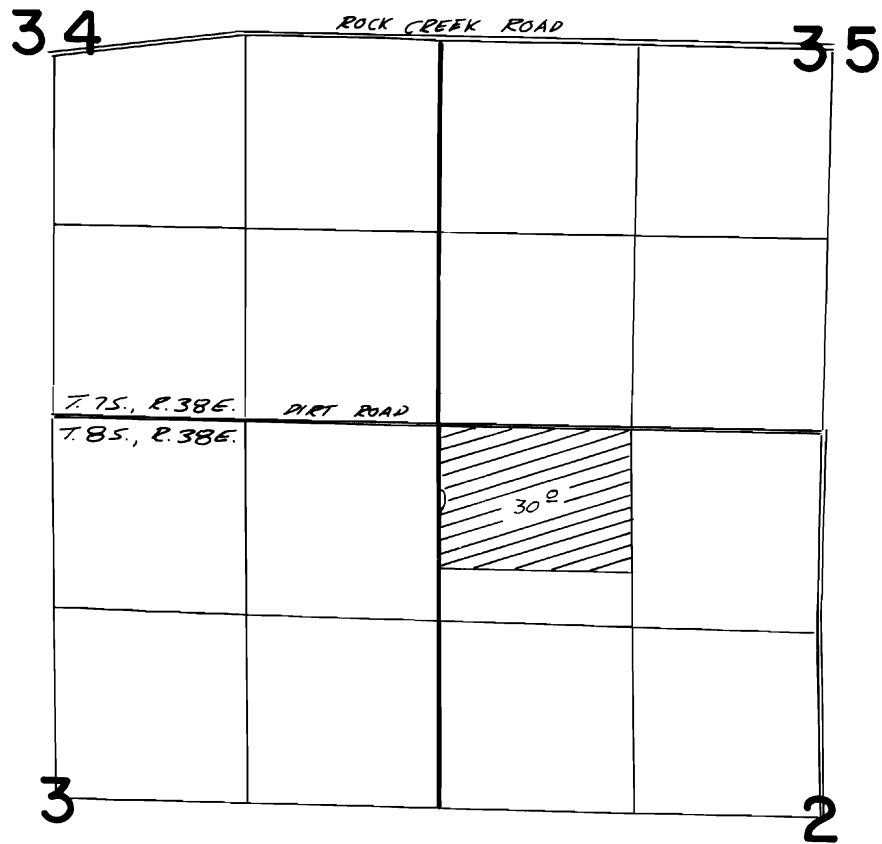

FINAL PROOF SURVEY

UNDER

TRANSFER 3673

IN NAME OF

JAMES E., TOM L. KERNS

Surveyed *April 12, 1982*, by *Vernon L. Church*