


T.5S.R.3W.W.M.

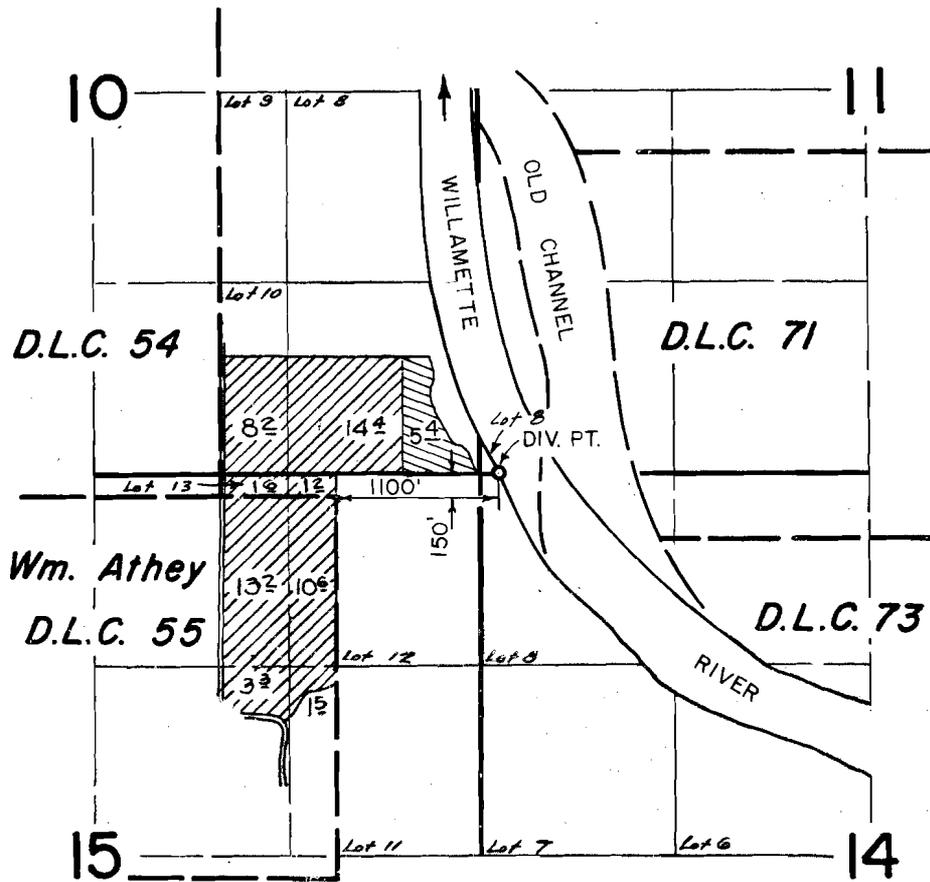

FINAL PROOF SURVEY
UNDER

TRANSFER NO. 3681
APPLICATION NO. 55961 PERMIT NO. 42114

IN NAME OF
ROGER HILDEBRANDT

SURVEYED MAY 28, 1980, BY *dlBraun*