


T. 7S., R. 38E., W.M.

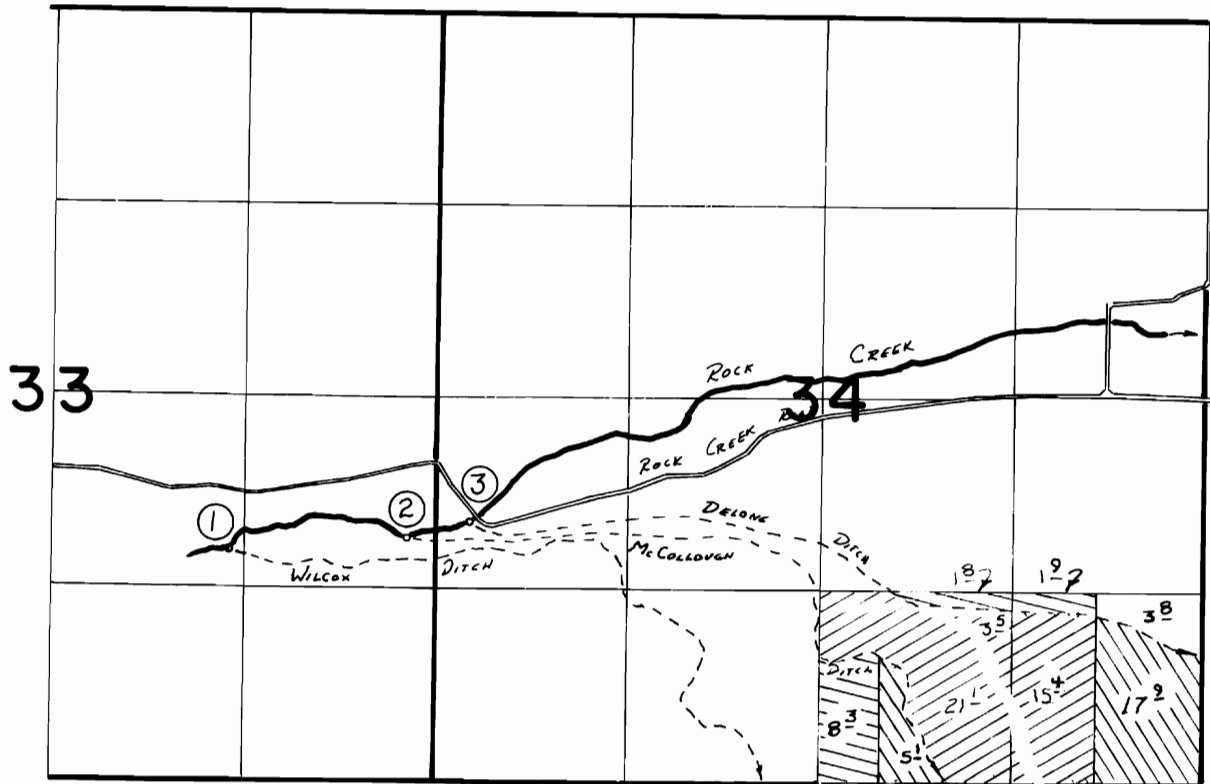




1. WILCOX DITCH Div. Pt. Loc: 1580'N. & 1430'W. FROM SE CORNER SECTION 33
2. MCCOLLOUGH DITCH Div. Pt. Loc: 1670'N. & 200'W. FROM SE CORNER SECTION 33
3. DELONG DITCH Div. Pt. Loc: 1790'N. & 230'E. FROM SW CORNER SECTION 34

**FINAL PROOF SURVEY**  
UNDER

**TRANSFER 3688**

IN NAME OF

**BILL & MARY DETHLOFF**

	1882
	1868
	1904



SCALE 1" = 1320'

Surveyed 8-5-1983, by *V.L. Church*