


# T. 9 S., R. 16 E., W.M.

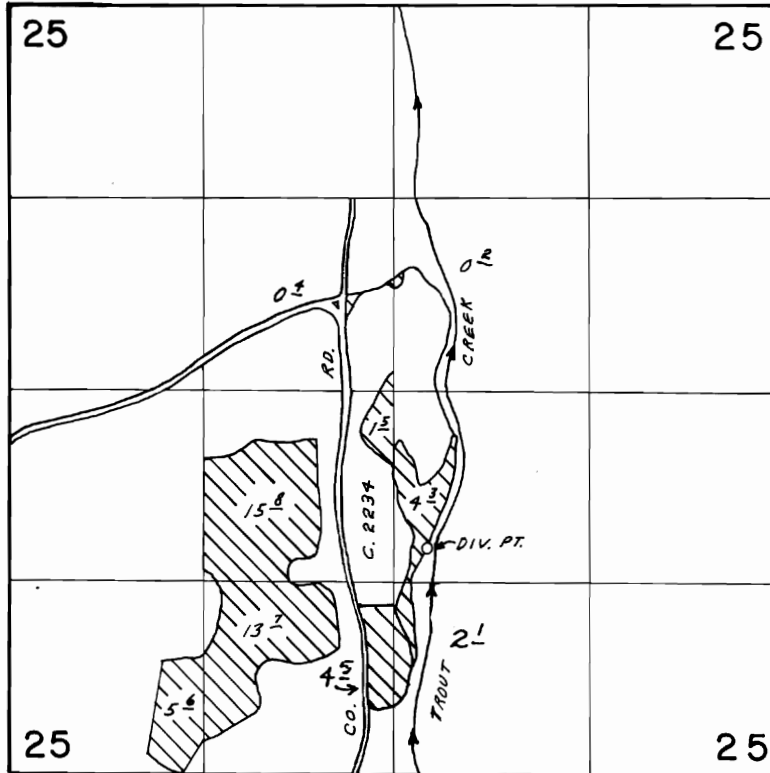

DIV. PT. LOC: 220' N. & 230' E FROM NW COR. OF SW 1/4 SE 1/4 SEC. 25

SCALE: 1" = 1320'

## FINAL PROOF SURVEY UNDER

TRANSFER 3690

Application No. 55999 Permit No. 42196.....

IN NAME OF

JIM NARTZ

Surveyed AUG. 18. 19. 88, by B. BISHOP.....

revised 6/26/2000 SCB  
12-2-88  
41013-279-85A LLC