


T. IS. R. 13E. W.M.

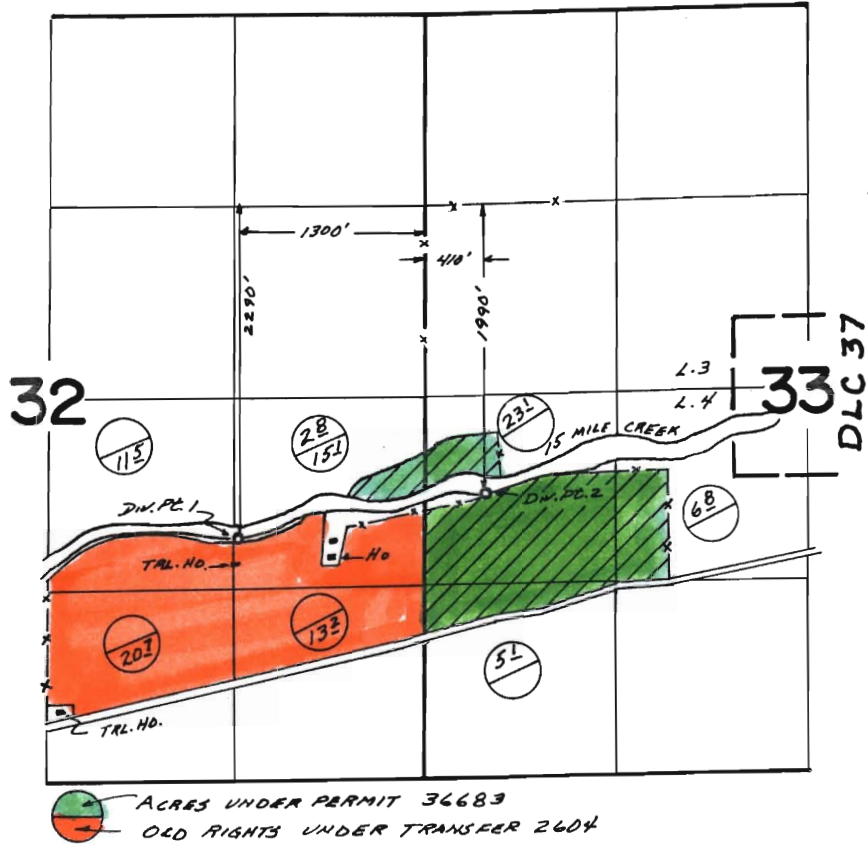

FINAL PROOF SURVEY UNDER

Transfer No. 2604
 Application No. 49002... Permit No. 36683...
 IN NAME OF

.....PAUL SCHANNO.....

Surveyed Oct. 21... 1975, by T. J. PAUL.....