


1"=200'

T #3700

To

See Map 16 12

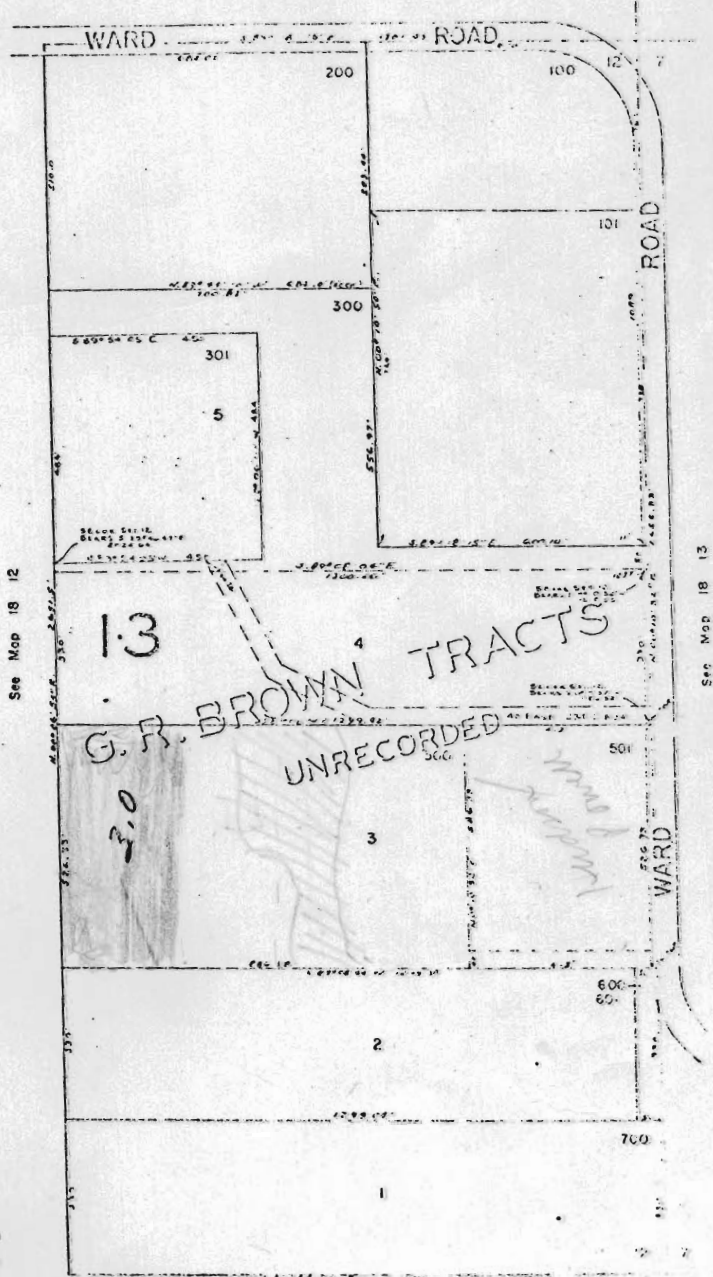

RECEIVED

JUN 10 1977

WATER RESOURCES DEPT
SALEM, OREGON

B. McCord 18-12-12 SE 1/4 of SE 1/4 3.0 ac. or
In Red

(To Bruce McCord)

