


T.14S. R.12E. W.M.

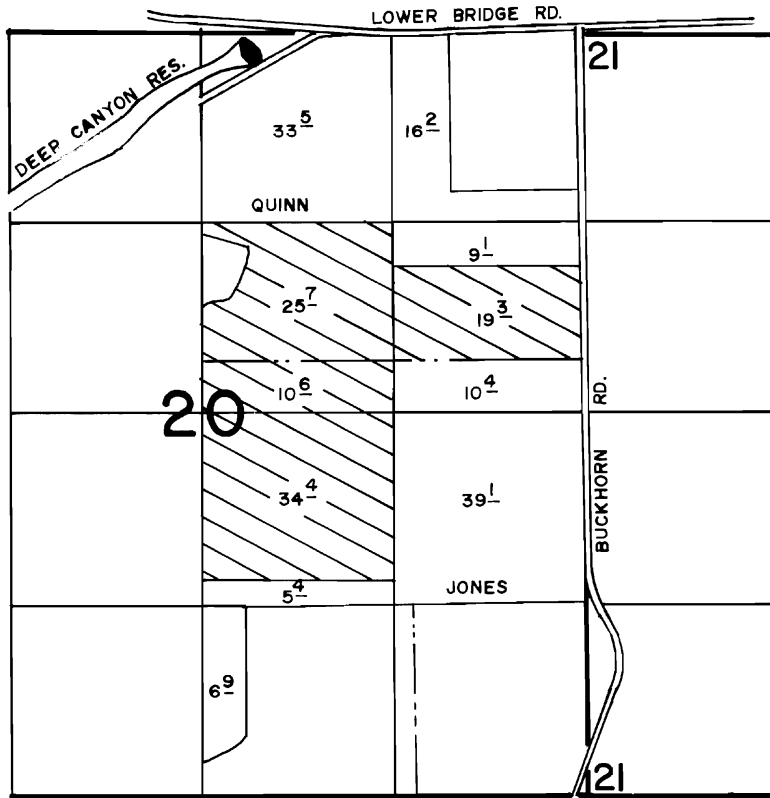

SUPERCEDED

FINAL PROOF SURVEY UNDER

TRANSFER NO. 3706

Application No. Permit No.
IN NAME OF

.....**JERRY JONES & JOE QUINN**.....

Surveyed APR...24.. 1980., by L.H...NUNN.....