


T. 36 S., R. 1 W., W.M.

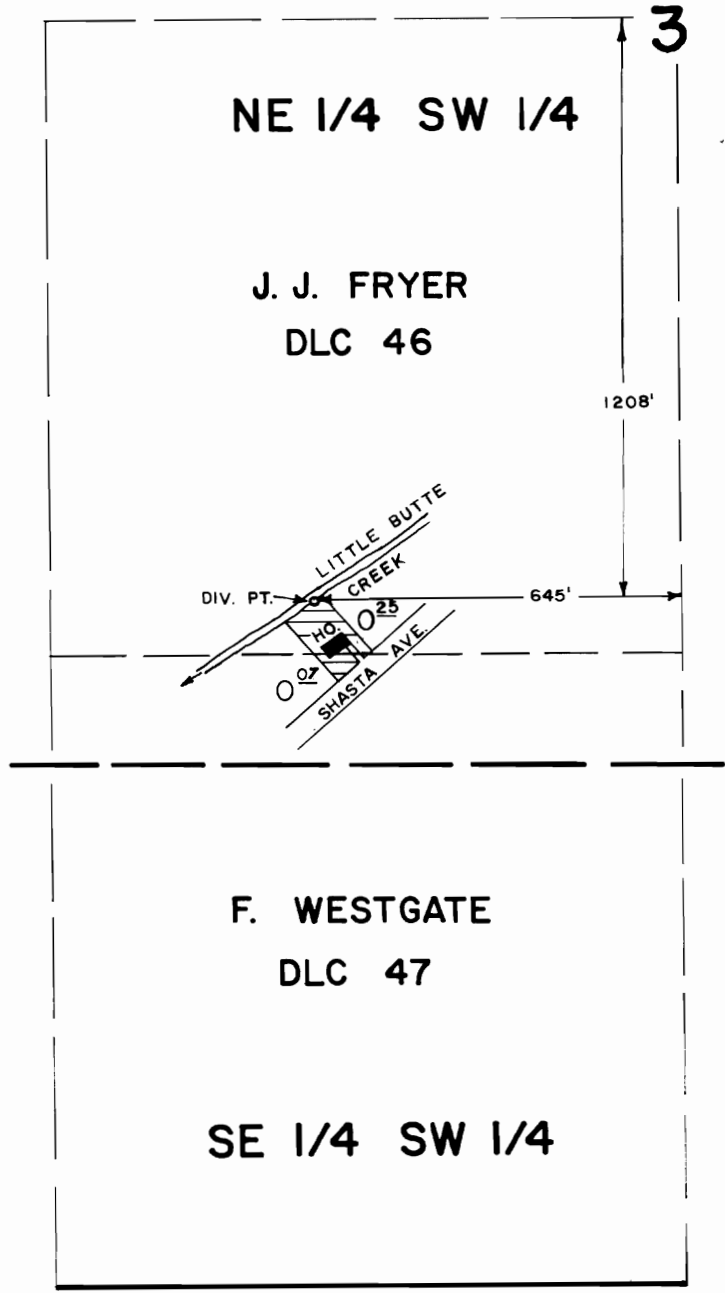

**FINAL PROOF SURVEY**  
UNDER

TRANSFER NO. 3725

Application No. .... Permit No. ....  
IN NAME OF

**PATRICK A. & CHRISTENE L. BLAKELY**

Surveyed AUG. 29, 1983, by B. SUZIE JAMES

SCALE: 1" = 400'