
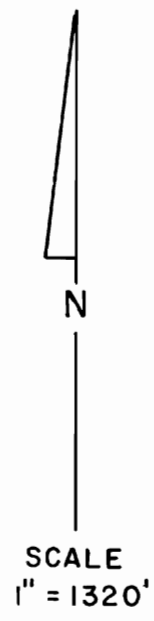


T. 9 S., R. 5 W., W. M.

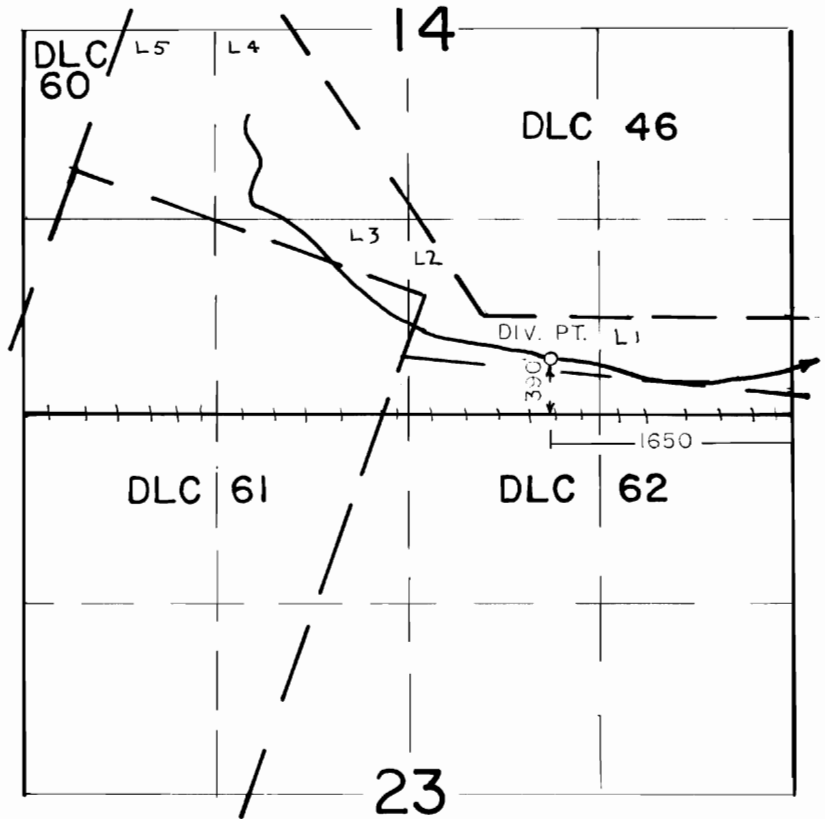

FINAL PROOF SURVEY
UNDER

TRANSFER 3727
IN NAME OF

DOROTHY DAVIES

Surveyed SEP. 5, 1984, by P. PAGTER