


T. 16S., R. 43 E., WM

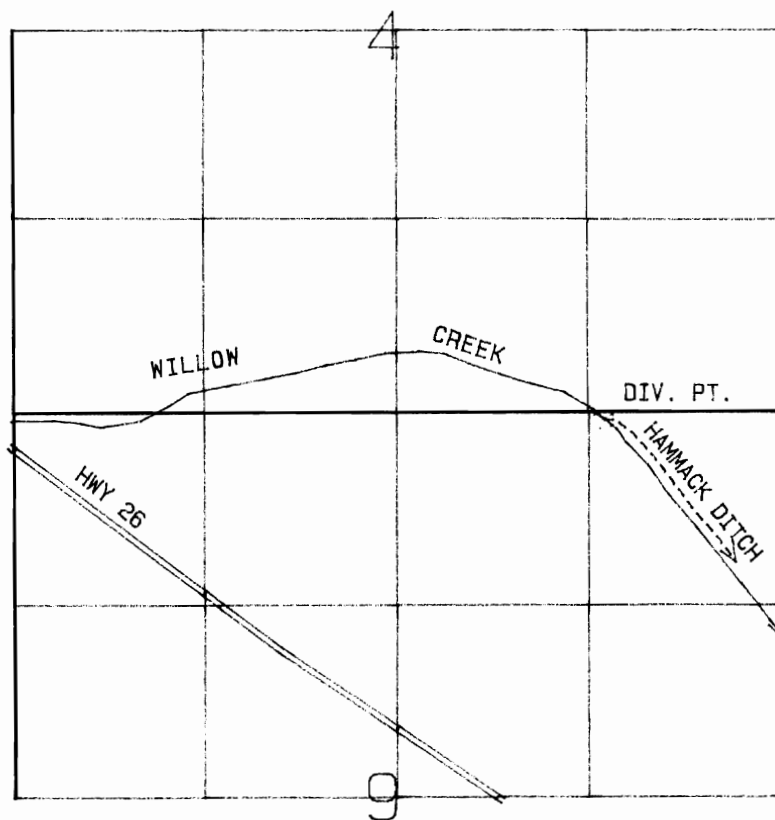

DIVERSION LOCATED: 30 FT. S. & 1240 FT. W. FROM  
THE NE CORNER OF SECTION 9

SCALE 1 IN = 1320 FT

FINAL PROOF SURVEY  
UNDER

TRANSFER NUMBER 3728

IN THE NAME OF

EMIL W. MAAG

SURVEYED JUNE 12, 1986 BY: VERN CHURCH

COMPUTER DRAFTED: BWB  
41045-178-95R