


**T.6S.R.1E.W.M.**

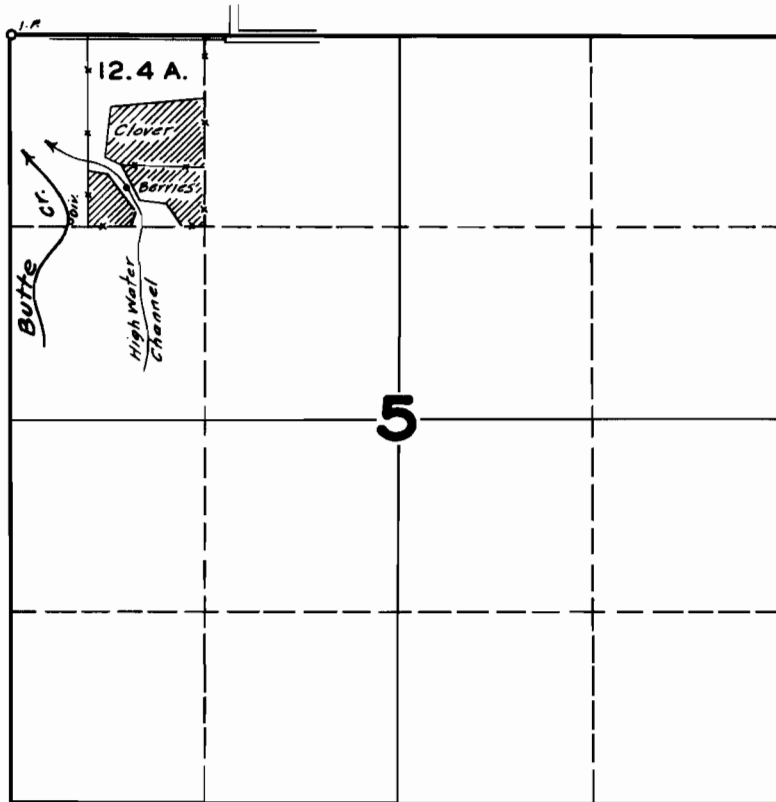

**FINAL PROOF SURVEY  
UNDER**

**Application No. 21811 Permit No. 17336**

**IN NAME OF**

**WALTER BERG**

**Surveyed OCT. 27 1947, by JAS. E. BUNNELL**