


T14S, R14E, WM

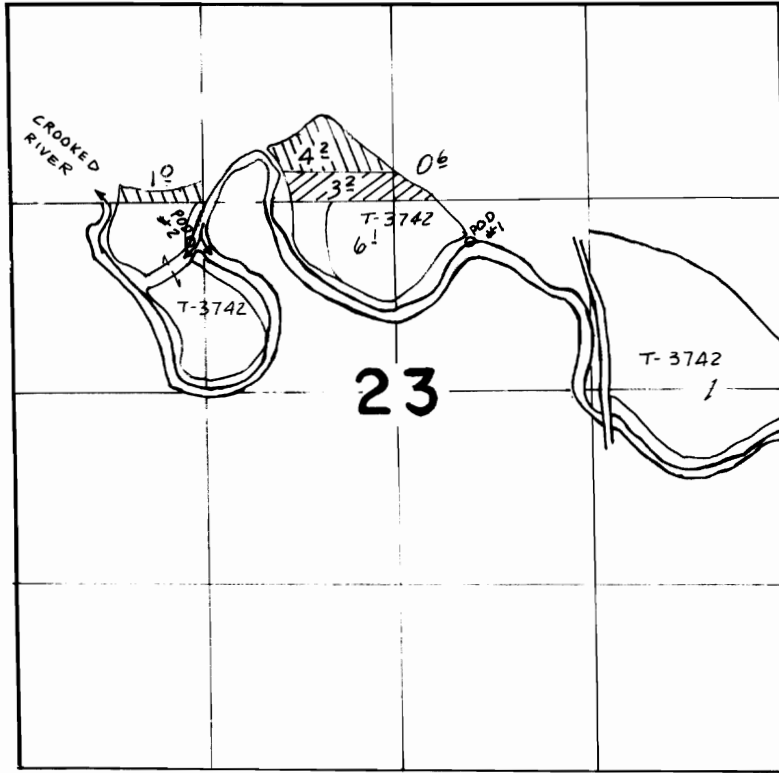

POD NO.1: 1020' N & 500' E } from C¹/₄ cor. Sec 23
POD NO.2: 1000' N & 1400' W)
POD NO.3: 450' W from E¹/₄ cor Sec. 24

FINAL PROOF SURVEY
UNDER

TRANSFER 5005 
TRANSFER 3742
Application No. Permit No.
IN NAME OF

.....
Surveyed July 27, 1979, by L.H. NUNN.....