


T.14S.,R.14E.,W.M.

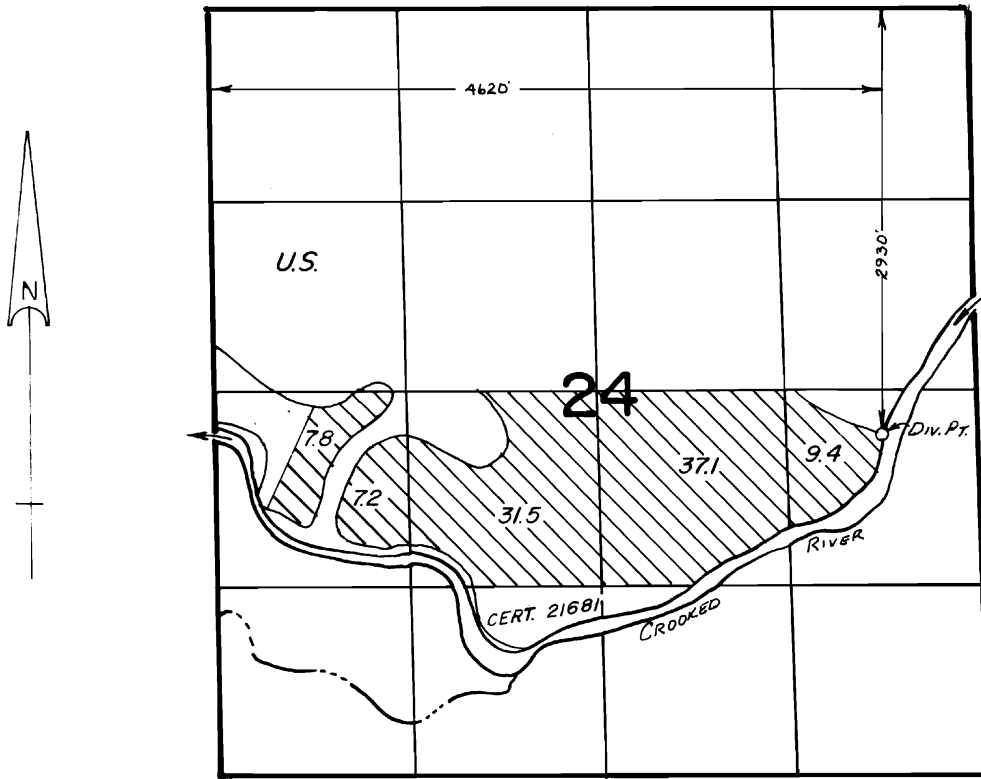

SCALE: 1" = 1320'

FINAL PROOF SURVEY UNDER

Transfer No. 3743
Application No. Permit No.
IN NAME OF

.....**RAFTER Q. CATTLE CO.**.....

Surveyed **JULY 27, 1979**, by **L.H. NUNN**.....